

FINISH SCHEDULE

SEE SHEET - ID2 & ID3 FOR FLOOR FINISH TERMINATION AND LOCATIONS
 SEE SHEET - ID4 & ID5 FOR WALL FINISH TERMINATION AND LOCATIONS
 SEE SHEET - ID8 FOR INTERIOR RESTROOM ELEVATIONS

FIRE & EOC CENTER 1ST FLOOR		WALLS						COMMENTS
RM. NO.	ROOM NAME	FLOOR	BASE	NORTH	SOUTH	EAST	WEST	
101	LOBBY	TZ1	VB1	P1	P4	P1	P1	
102	TREATMENT ROOM	V11	VB1	P1	P1	P1	P1	
103	RESTROOM	PT1	NA	PT1	PT1	PT1	PT1	
104	REPORT WRITING	CC2	VB1	P1	P1	P1	P1	
105	DAY ROOM	CC2	VB1	P1	P1	WC1	P1	NOTE: EAST WALL (WC1) TO RECEIVE FABRI TRAK WALL PANEL SYSTEM TACKABLE - PRODUCED BY BRAMBERS INC. MIAMI FLORIDA.
106	DINING	CC2	VB1	P1	P1	P1	P1	
107	KITCHEN	CC2	VB1	P1	P1	P1	P1	
108	RESTROOM	PT1/2	NA	PT1	PT1	PT1	PT1	NOTE: PT2- TILE SHOWER PAN ONLY
109	BUNK ROOM	V11	VB1	P1	P3	P1	P1	
110	BUNK ROOM	V11	VB1	P1	P3	P1	P1	
111	BUNK ROOM	V11	VB1	P1	P3	P1	P1	
112	BUNK ROOM	V11	VB1	P3	P1	P1	P1	
113	BUNK ROOM	V11	VB1	P3	P1	P1	P1	
114	BUNK ROOM	V11	VB1	P3	P1	P1	P1	
115	RESTROOM	PT1/2	NA	PT1	PT1	PT1	PT1	
116	LAUNDRY ROOM	CC2	VB1	P1	P1	P1	P1	
117	PANTRY	CC2	VB1	P1	P1	P1	P1	
118	PANTRY	CC2	VB1	P1	P1	P1	P1	
119	PANTRY	CC2	VB1	P1	P1	P1	P1	
120	JANITOR	CC2	VB1	P1	P1	P1	P1	
121	RESTROOM	PT1/2	NA	PT1	PT1	PT1	PT1	NOTE: PT2- TILE SHOWER PAN ONLY
122	BUNK ROOM	V11	VB1	P1	P3	P1	P1	
123	BUNK ROOM	V11	VB1	P1	P3	P1	P1	
124	BUNK ROOM	V11	VB1	P1	P3	P1	P1	
125	CORRIDOR	V11	VB1	P1	P1	P1	P1	
126	BUNK ROOM	V11	VB1	P3	P1	P1	P1	
127	BUNK ROOM	V11	VB1	P3	P1	P1	P1	
128	BUNK ROOM	V11	VB1	P3	P1	P1	P1	
129	RESTROOM	PT1/2	NA	PT1	PT1	PT1	PT1	NOTE: PT2- TILE SHOWER PAN ONLY
130	RESTROOM	PT1	NA	PT1	PT1	PT1	PT1	NOTE: PT2- TILE SHOWER PAN ONLY
131	CORRIDOR	V11	VB1	PT1	PT1	PT1	PT1	
132	BUNK ROOM	V11	VB1	P1	P3	P1	P1	
133	LIEUTENANT'S OFFICE	CC2	VB1	P1	P1	P1	P1	
134	BATTALION CHIEF OFFICE	CC2	VB1	P3	P1	P1	P1	
135	BUNK ROOM	V11	VB1	P3	P1	P1	P1	
136	BUNK ROOM	V11	VB1	P3	P1	P1	P1	
137	RESTROOM	PT1/2	NA	PT1	PT1	PT1	PT1	NOTE: PT2- TILE SHOWER PAN ONLY
138	BUNK ROOM	V11	VB1	P3	P1	P1	P1	
139	RESTROOM	PT1/2	NA	PT1	PT1	PT1	PT1	NOTE: PT2- TILE SHOWER PAN ONLY
	STAIR 1 & 2	TZ1	VB1	P1	P1	P8		NOTE: ACCENT PAINT WEST WALL - COLOR: TBD

FIRE & EOC CENTER 2ND FLOOR		WALLS						COMMENTS
RM. NO.	ROOM NAME	FLOOR	BASE	NORTH	SOUTH	EAST	WEST	
201	LOBBY	TZ1	VB1	P1	P1	P1	P1	
202	CONFERENCE ROOM	CP11	VB1	P1	P7	P1	P1	
203	FIRE INSPECTORS	CP11	VB1	P1	P1	P1	P1	
203A/B	ADA II - RECEPTIONIST/STORAGE	CP11	VB1	P6	P1	P1	P1	
204	PREV. DIVISION CHIEF	CP11	VB1	P1	P6	P1	P1	
205	EMS DIVISION CHIEF	CP11	VB1	P1	P6	P1	P1	
206	TRAINING DIVISION CHIEF	CP11	VB1	P6	P1	P1	P1	
207	DEPUTY CHIEF'S OFFICE	CP11	VB1	P6	P1	P1	P1	
208	ADMIN. ANALYST	CP11	VB1	P6	P1	P1	P1	
209	FIRE CHIEF'S OFFICE	CP11	VB1	P6	P1	P1	P1	
210	RESTROOM	PT1/2	NA	PT1	PT1	PT1	PT1	NOTE: PT2- TILE SHOWER PAN ONLY
213	RESTROOM	PT1/2	P81	PT1	PT1	PT1	PT1	NOTE: PT2- TILE SHOWER PAN
214	VISITOR SUITE	CP11	VB1	P6	P1	P1	P1	
215	VISITOR SUITE	CP11	VB1	P6	P1	P1	P1	
216	COMPUTER / DATA ROOM	V13	VB1	P1	P1	P1	P1	NOTE: STATIC DISSIPATIVE TILE VINYL COMPOSITION FLOORING (VT3) - ARMSTRONG INC
217	ELECTRIC ROOM	V11	VB1	PT1	PT1	PT1	PT1	
218	STORAGE	V11	VB1	P1	P1	P1	P1	
219A/B	RESTROOM	PT1	NA	PT1	PT1	PT1	PT1	
220A	WOMEN'S RESTROOM	PT1	NA	PT1	PT1	PT1	PT1	
220B	MEN'S RESTROOM	PT1	NA	PT1	PT1	PT1	PT1	
221	ADA II	CP11	VB1	P1	P1	P1	P1	
222	CERT. STORAGE	V11	VB1	P1	P1	P1	P1	
223	BREAK ROOM	V11/V12	VB1	P7	P1	P1	P1	NOTE: SEE FLOOR PATTERN SHT ID3
224	STORAGE	V11	VB1	P1	P1	P1	P1	
225	EOC/TRAINING ROOM	CP11	VB1	P1	P6	P1	P1	
226	RESTROOM	PT1	P81	PT1	PT1	PT1	PT1	
227	CONFERENCE ROOM	CP11	VB1	P7	P1	P1	P1	
228	CORRIDOR	TZ1	VB1	P1	P1	P1	P1	
229	CORRIDOR	CP11	VB1	P1/P6	P1	P6	P1	

FINISH NOTES:

WALLS
 (P1) PAINT ALL WALLS UNLESS OTHERWISE NOTED.
 CONTRACTOR TO PRIME EXISTING WALLS AS REQUIRED PRIOR TO FINISH PAINTING.
 ALL PAINT SHERWIN WILLIAMS AS NOTED ON THE FINISH SCHEDULE
 FOLLOW MANUFACTURER INSTRUCTION FOR PRIMING AND INSTALLATION
 ALL WET AREAS TO RECEIVE IMPERVIOUS PAINT FOR MOISTURE PREVENTION FLOORING.
 CONTRACTOR TO CLEAN SUB FLOOR AS REQUIRED TO INSTALL SPECIFIED FLOORING.
 MATERIAL TO BE COMPATIBLE WITH SCHEDULED FLOOR COVERING & BASE ADHESIVE.
 GO TO CHECK FOR MOISTURE LEVELS IN CONCRETE.
 SUBSTRATE (FLOOR) PRIOR TO INSTALLATION OF GOODS.
 ALL FLOORING TO BE INSTALLED BY A CERTIFIED FLOORING INSTALLER.
 USE SPECIFIED TR TRANSITION TYPE AT APPLICABLE INTERSECTIONS OF FLOORING MATERIALS.

ARCHITECT TO CONFIRM FINAL COLOR PRIOR TO FINAL PAINT INSTALLATION.
 G.C. MUST COMPLETE TEST PANELS FOR FINAL APPROVAL.

INTERIOR WINDOW TREATMENTS: SEE ID WALL FINISH PLAN SHEETS ID4 FIRST FLOOR & ID5 SECOND FLOOR- FOR LOCATION, TYPES AND PRODUCT CONTACT INFORMATION. FOR DETAILED SPECIFICATIONS REFER TO ARCHITECTURAL SPECIFICATIONS. NOTE: FINAL FINISH COLOR TO BE REVIEWED AND APPROVED BY CLIENT PRIOR TO PURCHASE.

ALL PAINTED AREAS TO RECEIVE 1 PRIMER COAT - 2 FINISH COATS MINIMUM

INTERIOR FINISH SPECIFICATIONS

REFER TO ARCHITECT'S MASTER SPECIFICATIONS

ALL FINISHES SHALL MEET THE REQUIREMENTS OF NFPA 101 (CURRENT EDITION) SECTION 27.3.3.1 FLAME SPREAD AND SMOKE GENERATION.
 INSTALLATION NOTE: INSTALLER TO FOLLOW MANUFACTURER'S INSTALLATION.

FLOORING	DETAILS
CC1	MANUFACTURER: SCOFIELD INC. PRODUCT: FORMULA ONE - LIQUID DYE CONCENTRATE- PLAIN CONCRETE-GRADE1- CLASS 3-GUARD- 5' FLA. SCREENING SR839 CONTACT: 1-800-808-9900. SEE PATTERN LOCATION SHEETS ID2 ID3. FOLLOW MANUFACTURER'S RECOMMENDATIONS FOR PREP, INSTALLATION & MAINTENANCE. FINISH: NONE. POSIB: REFER TO ARCHITECTURAL SPECIFICATIONS.
CC2	MANUFACTURER: SCOFIELD INC. PRODUCT: FORMULA ONE - LIQUID DYE CONCENTRATE- PLAIN CONCRETE-GRADE1- CLASS 3-GUARD- 5' FLA. SCREENING SR839 CONTACT: 1-800-808-9900. SEE PATTERN LOCATION SHEETS ID2 ID3. FOLLOW MANUFACTURER'S RECOMMENDATIONS FOR PREP, INSTALLATION & MAINTENANCE. FINISH: REFER TO ARCHITECTURAL SPECIFICATIONS.
PT1	MANUFACTURER: DACTILE PRODUCT: FULL BODY PORCELAIN - C.O.F. LESS THAN 0.42 PER ISO9 ACUTEST METHOD. SIZE: 11 3/4" X 23 9/16" UNPOLISHED - COLOR: DRUGO P402 GROUT: MANUFACTURER: LATICRETE- SPECTRALOCK PRO GROUT (EPOXY) 1/16" WIDE GROUT JOINTS. COLOR: 24 NATURAL GREY CONTACT: 1-800-833-1111. SEE PATTERN LOCATION SHEETS ID2 ID3. FOLLOW MANUFACTURER'S RECOMMENDATIONS FOR PREP, INSTALLATION & MAINTENANCE.
PT2	MANUFACTURER: DACTILE PRODUCT: FULL BODY PORCELAIN - C.O.F. LESS THAN 0.42 PER ISO9 ACUTEST METHOD. SIZE: 11 3/4" X 23 9/16" UNPOLISHED - COLOR: DRUGO P402 GROUT: MANUFACTURER: LATICRETE- SPECTRALOCK PRO GROUT (EPOXY) 1/16" WIDE GROUT JOINTS. COLOR: 24 NATURAL GREY CONTACT: 1-800-833-1111. SEE PATTERN LOCATION SHEETS ID2 ID3. FOLLOW MANUFACTURER'S RECOMMENDATIONS FOR PREP, INSTALLATION & MAINTENANCE.
PT12	PRODUCT: TERRAZZO POURED FLOOR - SEE ARCHITECTURAL SPECIFICATIONS FOR PRODUCT DETAILS & SPECIFICATIONS. SEE PATTERN LOCATION SHEETS ID2 ID3. FOLLOW MANUFACTURER'S RECOMMENDATIONS FOR PREP, INSTALLATION & MAINTENANCE.
CP11	MANUFACTURER: PATCOAT - PRODUCT STYLE NAME: EASY ON THE EYES - STYLE # 10227 PILE CONSTRUCTION: MULTI-LEVEL LOOP - PILE FIBER & TYPE: ECO SOLUTION 0 NYLON- DYE METHOD: 100% SOLUTION DYED - TUFTED YARN WEIGHT: 180Z PILE CONTACT: 1-800-241-4014 - SEE PATTERN LOCATION SHEETS ID2 ID3. FOLLOW MANUFACTURER'S RECOMMENDATIONS FOR PREP, INSTALLATION & MAINTENANCE.
V11	MANUFACTURER: PATCOAT - PRODUCT STYLE NAME: TYPOGRAPHY - CONST: LVT - WEAR LAYER: 20 MIL - WEAR LAYER THICKNESS: .020" OVER ALL THICKNESS: .086" REF. SPEC. ASTM F 1700 CLASS II PRINTED FILM VINYL TILE TYPE A C SMOOTH, FINISH: ENDOGLAU QUARTZ ENHANCED URETHANE RECOMMENDED ADHESIVE: SHAW 4100 OR S150. COLOR: TYPEFACE- EXCLAMATION 0480. SIZE: 23 5/8" X 23 5/8" - INSTALLATION: MONOLITHIC. NOTE: FIELD TILE CONTACT: 1-800-241-4014 - SEE PATTERN LOCATION SHEETS ID2 ID3. FOLLOW MANUFACTURER'S RECOMMENDATIONS FOR PREP, INSTALLATION & MAINTENANCE.
V12	MANUFACTURER: PATCOAT - PRODUCT STYLE NAME: TYPOGRAPHY - CONST: LVT - WEAR LAYER: 20 MIL - WEAR LAYER THICKNESS: .020" OVER ALL THICKNESS: .086" REF. SPEC. ASTM F 1700 CLASS II PRINTED FILM VINYL TILE TYPE A C SMOOTH, FINISH: ENDOGLAU QUARTZ ENHANCED URETHANE RECOMMENDED ADHESIVE: SHAW 4100 OR S150. COLOR: LETTERPRESS- EXCLAMATION 0480. SIZE: 23 5/8" X 23 5/8" - INSTALLATION: MONOLITHIC. NOTE: ACCENT TILE CONTACT: 1-800-241-4014 - SEE PATTERN LOCATION SHEETS ID2 ID3. FOLLOW MANUFACTURER'S RECOMMENDATIONS FOR PREP, INSTALLATION & MAINTENANCE.
V13	MANUFACTURER: ARMSTRONG INC. - PRODUCT - VCT STATIC DISSIPATIVE TILE - #51950 MARBLE BEIGE- SIZE: 12" X 12" X 1/8" VINYL COMPOSITION TILE REFER TO ARCHITECTURAL SPECIFICATIONS
RF1	MANUFACTURER: AMORUM SPORTS FLOOR- SERIES : NUCLEAR - COLOR: GREEN MEADOWS 626-80 (FINAL COLOR TBD) REFER TO ARCHITECTURAL SPECIFICATIONS
BASE	
VB1	MANUFACTURER: JOHNSONITE CO PRODUCT: MILLWORK PROFILE- REVEAL SERIES. SIZE: 25"THICK X 4.25". PRODUCT CODE: MW-63-F. ACTUAL COLOR: BURNT UMBER. CONTACT: 1-800-899-8916. FOLLOW MANUFACTURER'S RECOMMENDATIONS FOR PREP, INSTALLATION & MAINTENANCE

WALL TREATMENT	DETAILS
P1	MANUFACTURER: SHERWIN WILLIAMS - COLOR: SW6154 NACRE - PRO MAR 200 0 VOC -LATEX SATIN FINISH FOLLOW MANUFACTURER'S RECOMMENDATIONS FOR INSTALLATION & MAINTENANCE.
P2	MANUFACTURER: SHERWIN WILLIAMS - COLOR: SW7005 PURE WHITE - PRO MAR 200 0 VOC -FLAT CEILING PAINT FOLLOW MANUFACTURER'S RECOMMENDATIONS FOR INSTALLATION & MAINTENANCE.
P3	MANUFACTURER: SHERWIN WILLIAMS - COLOR: SW6153 SAWDUST - PRO MAR 200 0 VOC -LATEX SATIN FINISH FOLLOW MANUFACTURER'S RECOMMENDATIONS FOR INSTALLATION & MAINTENANCE.
P4	MANUFACTURER: SHERWIN WILLIAMS - COLOR: SW6213 HALCYON GREEN - PRO MAR 200 0 VOC -LATEX SATIN FINISH FOLLOW MANUFACTURER'S RECOMMENDATIONS FOR INSTALLATION & MAINTENANCE.
P5	MANUFACTURER: SHERWIN WILLIAMS - COLOR: SW6768 MARCH WINDS - PRO MAR 200 0 VOC -LATEX SATIN FINISH FOLLOW MANUFACTURER'S RECOMMENDATIONS FOR INSTALLATION & MAINTENANCE.
P6	MANUFACTURER: SHERWIN WILLIAMS - COLOR: SW6764 SLATE TILE - PRO MAR 200 0 VOC -LATEX SATIN FINISH FOLLOW MANUFACTURER'S RECOMMENDATIONS FOR INSTALLATION & MAINTENANCE.
P7	MANUFACTURER: SHERWIN WILLIAMS - COLOR: SW6731 VERDANT - PRO MAR 200 0 VOC -LATEX SATIN FINISH FOLLOW MANUFACTURER'S RECOMMENDATIONS FOR INSTALLATION & MAINTENANCE.
P8	MANUFACTURER: SHERWIN WILLIAMS - COLOR: SW6735 DETERMINED ORANGE - PRO MAR 200 0 VOC -LATEX SATIN FINISH FOLLOW MANUFACTURER'S RECOMMENDATIONS FOR INSTALLATION & MAINTENANCE.
WC1	MANUFACTURER: KNOLL TEXTILES INC. - NAME: ALIAS-24/7 COLLECTION- STYLE NUMBER: WC1553/9 (UNBACKED) WRAPPED ACOUSTICAL PANELS- CONTENT: POLYETHYLENE 100%- FINISH: TEFLON SOIL & STAIN REPELLENT. TYPE:WEIGHT: TYPE II 10.5 OZ. PER LINEAL YD. - WIDTH: 54" FLAME RESISTANCE: ASTM E- 84 CLASS A. MAINTENANCE: WATER BASED/CLEANING AGENT, OR DILUTED HOUSEHOLD BLEACH. ENVIRONMENTAL: 100% SOLUTION DYED FIBER- GREENGLAUB CERTIFIED CONTRIBUTES TO LEED CERTIFICATION. CONTACT: 1-800-833-1111. SEE PATTERN LOCATION SHEETS ID2 ID3. FOLLOW MANUFACTURER'S RECOMMENDATIONS FOR PREP, INSTALLATION & MAINTENANCE.

PLASTIC LAMINATE- SOLID SURFACE/MILLWORK	DETAILS
PL1	MANUFACTURER: NEVAMAR DECORATIVE SURFACES INC. PRODUCT: ARMORED PROTECTION PLASTIC LAMINATE- COLOR: GUNMETAL S6020T FOLLOW MANUFACTURER'S INSTALLATION AND MAINTENANCE RECOMMENDATIONS. CONTACT: 1-800-638-4380.
PL2	MANUFACTURER: FORMICA INC. PRODUCT: ARTISAN FINISH PLASTIC LAMINATE- COLOR: VOSGES PEAR #1150 43 FOLLOW MANUFACTURER'S INSTALLATION AND MAINTENANCE RECOMMENDATIONS. CONTACT: 1-800-638-4380.
PL3	MANUFACTURER: NEVAMAR DECORATIVE SURFACES INC. PRODUCT: ARMORED PROTECTION PLASTIC LAMINATE- COLOR:ICONIC MAPLE - WIM09471 FOLLOW MANUFACTURER'S INSTALLATION AND MAINTENANCE RECOMMENDATIONS. CONTACT: 1-800-638-4380.
PL4	MANUFACTURER: CHEMETAL INC. PRODUCT: SOLID METAL WITH PATTERN- PRODUCT # - 300 SERIES- 020" SOLID METAL - COLOR #: 349 FACTORY SIZE: 96" X 48" PER SHEET INSTALL RAILROAD- PATTERN LAYOUT TO BE DOMINATE HORIZONTAL. FOLLOW MANUFACTURER'S INSTALLATION AND MAINTENANCE RECOMMENDATIONS. CONTACT: 1-800-638-4380.
PL5	MANUFACTURER: NEVAMAR DECORATIVE SURFACES INC. PRODUCT: ARMORED PROTECTION PLASTIC LAMINATE- COLOR: WROUGHT IRON S6064T FOLLOW MANUFACTURER'S INSTALLATION AND MAINTENANCE RECOMMENDATIONS. CONTACT: 1-800-638-4380.
PL6	MANUFACTURER: FORMICA INC. PRODUCT: PLASTIC LAMINATE- COLOR: MATTIE BLACK FOLLOW MANUFACTURER'S INSTALLATION AND MAINTENANCE RECOMMENDATIONS. CONTACT: 1-800-638-4380.
SS1	MANUFACTURER: CAMBRIA - PRODUCT: SOLID SURFACE QUARTZITE MAN MADE MATERIAL POLISHED- PRODUCT #: FIELDSTONE - DESERT COLLECTION # 2160- SIZE 2 CM- EDGE -STRAIGHT FOLLOW MANUFACTURER'S RECOMMENDATIONS FOR INSTALLATION AND MAINTENANCE
SS2	MANUFACTURER: CORIAN- PRODUCT: FOSSIL COUNTER W INTEGRAL BOWL REFER TO ARCHITECTURAL SPECIFICATIONS FOR DETAILS (RE: MATERIAL COMPOSITION, PRODUCT MODEL # ETC)

TOILET PARTITIONS	DETAILS
TPP	MANUFACTURER: SCRANTON PRODUCTS INC. - PRODUCT: HINY HDERS FINISH- STAINLESS EX- REFER TO ARCHITECTURAL SPECIFICATIONS FOR DETAILS (RE: MATERIAL COMPOSITION, PRODUCT MODEL # ETC)

CEILING TILES LAY-IN AND SPLINES	DETAILS
CLG1	MANUFACTURER: ARMSTRONG INC. - PRODUCT CALLA BEVEL REGULAR EDGE LAT-IN TILE - SIZE: 2' X 2' LAY-IN BEVEL REGULAR EDGE DETAIL- COLOR: WHITE- MODEL #: 2822- DESCRIPTION: MINERAL FIBER W/ACOUSTICALLY TRANSPARENT MEMBRANE - NRC: 0.85- RECYCLED CONTENT 98%. CEILING GRID: ARMSTRONG INC. 918" SUPRAGRID - WHITE

CABINERY FINISH SCHEDULE - PLASTIC LAMINATE & SOLID SURFACE

FOR FINISH INFORMATION ONLY NOT CONSTRUCTION- REFER TO MILLWORK SHOP DRAWINGS/ARCHITECTURAL DRAWINGS FOR DETAILS

FIRST FL	ROOM#	UPPERCASE	BACKSPLASH	COUNTER	BASE CABINET	TRANSACTION TOP	COMMENTS
TOILET	103	NA	NA	NA	NA		NOTE ADA WALL MOUNTED SINK
REPORT WRITING	104	NA	NA	NA	PL6		
DINING	106	NA	SS1	SS1	PL2		
KITCHEN	107	SEE ARCH DWGS	SEE ARCH DWGS	SEE ARCH DWGS	SEE ARCH DWGS		
BATH	108	NA	SS2	SS2	PL3		
BATH	115	NA	SS2	SS2	PL3		
LAUNDRY	116	PL2	NA	NA	NA		
PANTRY	117	SEE ARCH. DRWGS.	SEE ARCH. DRWGS.	SEE ARCH. DRWGS.	SEE ARCH. DRWGS.		
PANTRY	118	SEE ARCH. DRWGS.	SEE ARCH. DRWGS.	SEE ARCH. DRWGS.	SEE ARCH. DRWGS.		
PANTRY	119	SEE ARCH. DRWGS.	SEE ARCH. DRWGS.	SEE ARCH. DRWGS.	SEE ARCH. DRWGS.		
BATH	121	NA	SS2	SS2	PL3		
BATH	129	NA	SS2	SS2	PL3		
BATH	130	NA	NA	NA	NA		NOTE ADA WALL MOUNTED SINK
NOTE: BUNK ROOMS - 109,110,111,112,113,114,122,123,124,126,127,128,132,135,136,138 - FINISH TO BE (PL5)- BUILT-IN LOCKERS SEE ARCH. DRWS FOR DETAILS							
2ND FLOOR	ROOM#	UPPERCASE	BACKSPLASH	COUNTER	BASE CABINET	TRANSACTION TOP	COMMENTS
ADA II- RECEPTION	203A	NA	PL3	PL3	SEE COMMENTS	SS1	NOTE: PL1- VERTICAL INTERIOR FACADE NOTE: PL4- VERTICAL EXTERIOR FACADE NOTE: PL7- ALL SHELVING FINISH
STORAGE	203B	NA	NA	NA	NA		
BATH	210	NA	SS2	SS2	PL3		
CORRIDOR	211	NA	SS2	SS2	PL1		
BATH	212	NA	SS2	SS2	PL3		
BATH	213	NA	SS2	SS2	PL3		
BATH	220A	NA	SS2	SS2	PL3		
BATH	220B	NA	SS2	SS2	PL3		
BREAK ROOM	223	PL2	PL1	PL1	PL2		
BATH	226	NA	SS2	SS2	PL1		
CONFERENCE	227	NA	SS1	SS1	PL2		

ID DRAWING INDEX

ID-1 INTERIOR FINISH SPECIFICATIONS & SCHEDULE
 ID-2 INTERIOR FLOOR FINISH PLAN 1ST FLOOR
 ID3-INTERIOR FLOOR FINISH PLAN 2ND FLOOR
 ID4-INTERIOR WALL FINISH PLAN 1ST FLOOR
 ID5-INTERIOR WALL FINISH PLAN 2ND FLOOR
 ID6-FURNITURE PLAN 1ST FLOOR
 ID7-FURNITURE PLAN 2ND FLOOR
 ID8-INTERIOR RESTROOM ELEVATIONS - INTERIOR FINISH CODES
 ID9-WALL PANEL DETAIL

GENERAL NOTES:

ALL INTERIOR FINISH SAMPLES MUST BE SUBMITTED TO AES INTERIORS & ARCHITECT FOR FINAL SIGN OFF & APPROVAL PRIOR TO CONTRACTOR PURCHASE OR INSTALLATION OF THE SPECIFIED MATERIALS.
 THESE DRAWINGS ARE FOR DESIGN INTENT ONLY NOT FOR CONSTRUCTION
 CONTRACTOR MUST CHECK AVAILABILITY FOR ALL FINISHES UPON AWARD OF THE PROJECT TO ENSURE PRODUCTS ARE ORDERED IN A TIMELY FASHION. LEAD TIMES ARE CONSIDERED. IF ANY PRODUCT SPECIFIED HAS A LEAD TIME GREATER THAN 6 WEEKS THE GC TO NOTIFY THE INTERIOR DESIGNER FOR RE-SELECTION OF SPECIFIED PRODUCT.
 COORDINATE ID PLANS WITH CSA ARCHITECTURE INC. 561-276-4951

FLOORING TRANSITION DETAILS TAG TR-

NOTE: TRANSITION DETAILS SPECIFIED, ARE PER MANUFACTURER'S RECOMMENDATIONS PRIOR TO DETAILED INSTALLATION MEETING WITH ALL PARTIES MUST TAKE PLACE TO DETERMINE EXACT TRANSITION REQUIREMENTS.

Schluter® - RENO-U
 TR-1 RENO-U AEU125 - PORCELAIN TILE TO VINYL (ANODIZED ALUMINUM)

Schluter® - RENO-V
 TR-2 RENO-V AEU 200 B20 - CONCRETE OR TERRAZZO TO PORCELAIN, VINYL, CARPET TILE, OR RUBBER FLOORING (ANODIZED ALUMINUM)

Schluter® - RENO-TK
 TR-3 RENO-TK AETK 60 - CARPET TILE TO PORCELAIN TILE OR VINYL (ANODIZED ALUMINUM)

Schluter® - DECO-E
 TR-4 SCHIENE DECO E 2500 - CONCRETE TO TERRAZZO (STAINLESS STEEL)

Schluter® - SCHIENE
 TR-5 SCHIENE AE 250 - CONCRETE OR TERRAZZO AT ELEVATOR (STAINLESS STEEL)

PROJECT NAME:
FIRE & EOC CENTER HALLANDALE, FL
 111 FOSTER ROAD HALLANDALE BEACH, FL. 33009
STATION # 7


SEAL

PROJECT NO:
 2014.17
DRAWN BY: DC
CHECKED BY: AES
DATE: 04-09-2015

FILE NAME:
 1ST FLOOR
 FL. FINISH
 PLAN

SHEET NO.

ID-2

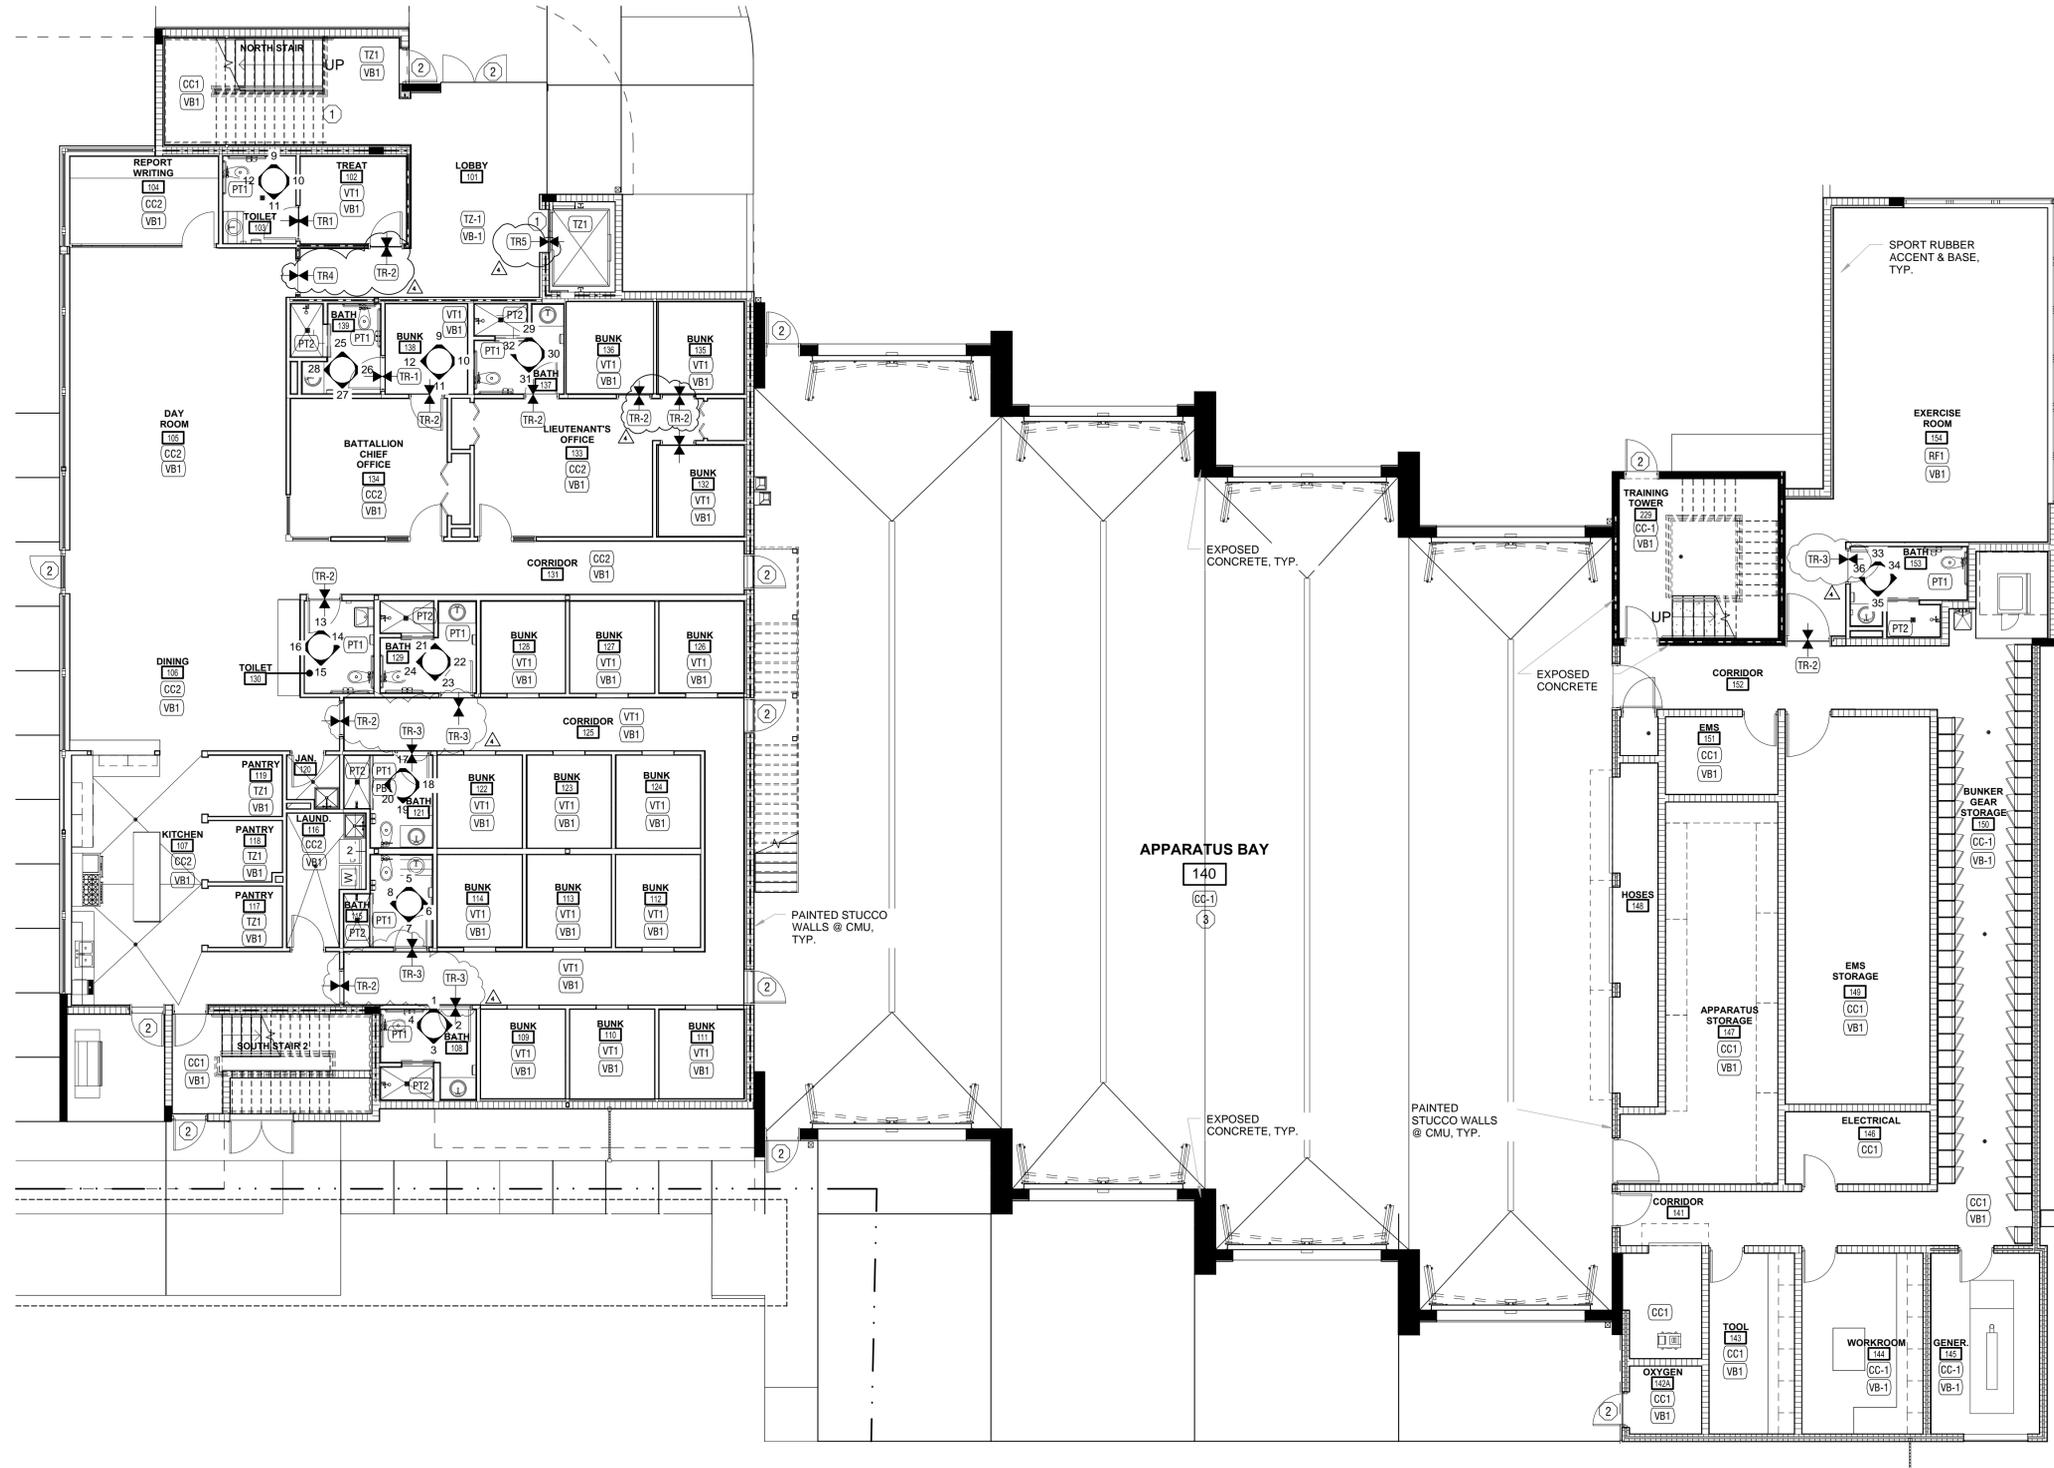


FIRST FLOOR FINISH PLAN
 SCALE: 1/8" = 1'-0"



NOTES THIS PLAN:

- ① COORDINATE FLOORING THRESHOLD AT STAIRS & ELEVATOR WITH FLOORING CONTRACTOR FOR DETAILS.
- ② COORDINATE FLOOR THRESHOLD TO EXTERIOR OF BUILDING W/ ARCHITECT. REFER TO ARCHITECTURAL DRAWINGS.
- ③ ROOM #140-#152 REFER TO ARCHITECTURAL PLANS FOR ID FINISHES.

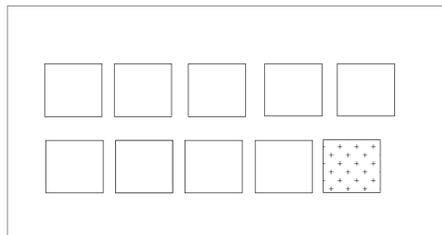

FINISH PLAN LEGEND

-  KEY NOTE: SEE FLOOR FINISH LEGEND THIS SHEET.
-  FINISH SCHEDULE NOTATION- SEE SHT ID- FOR SPECIFICATIONS
-  TR- TRANSITION POINT BETWEEN FINISHES.

REVISION:	DATE:
1	5-15-15
2	5-20-15
3	7-10-15
4	8-10-15
5	8-24-15 BID SET


PROJECT NAME:
FIRE & EOC CENTER HALLANDALE, FL
 111 FOSTER ROAD HALLANDALE BEACH, FL. 33009
STATION # 7

SEAL

PROJECT NO: 2014.17
DRAWN BY: AES
CHECKED BY: AES
DATE: 04-9-2015

FILE NAME: 2ND FLOOR FL. FINISH PLAN

SHEET NO. ID-3

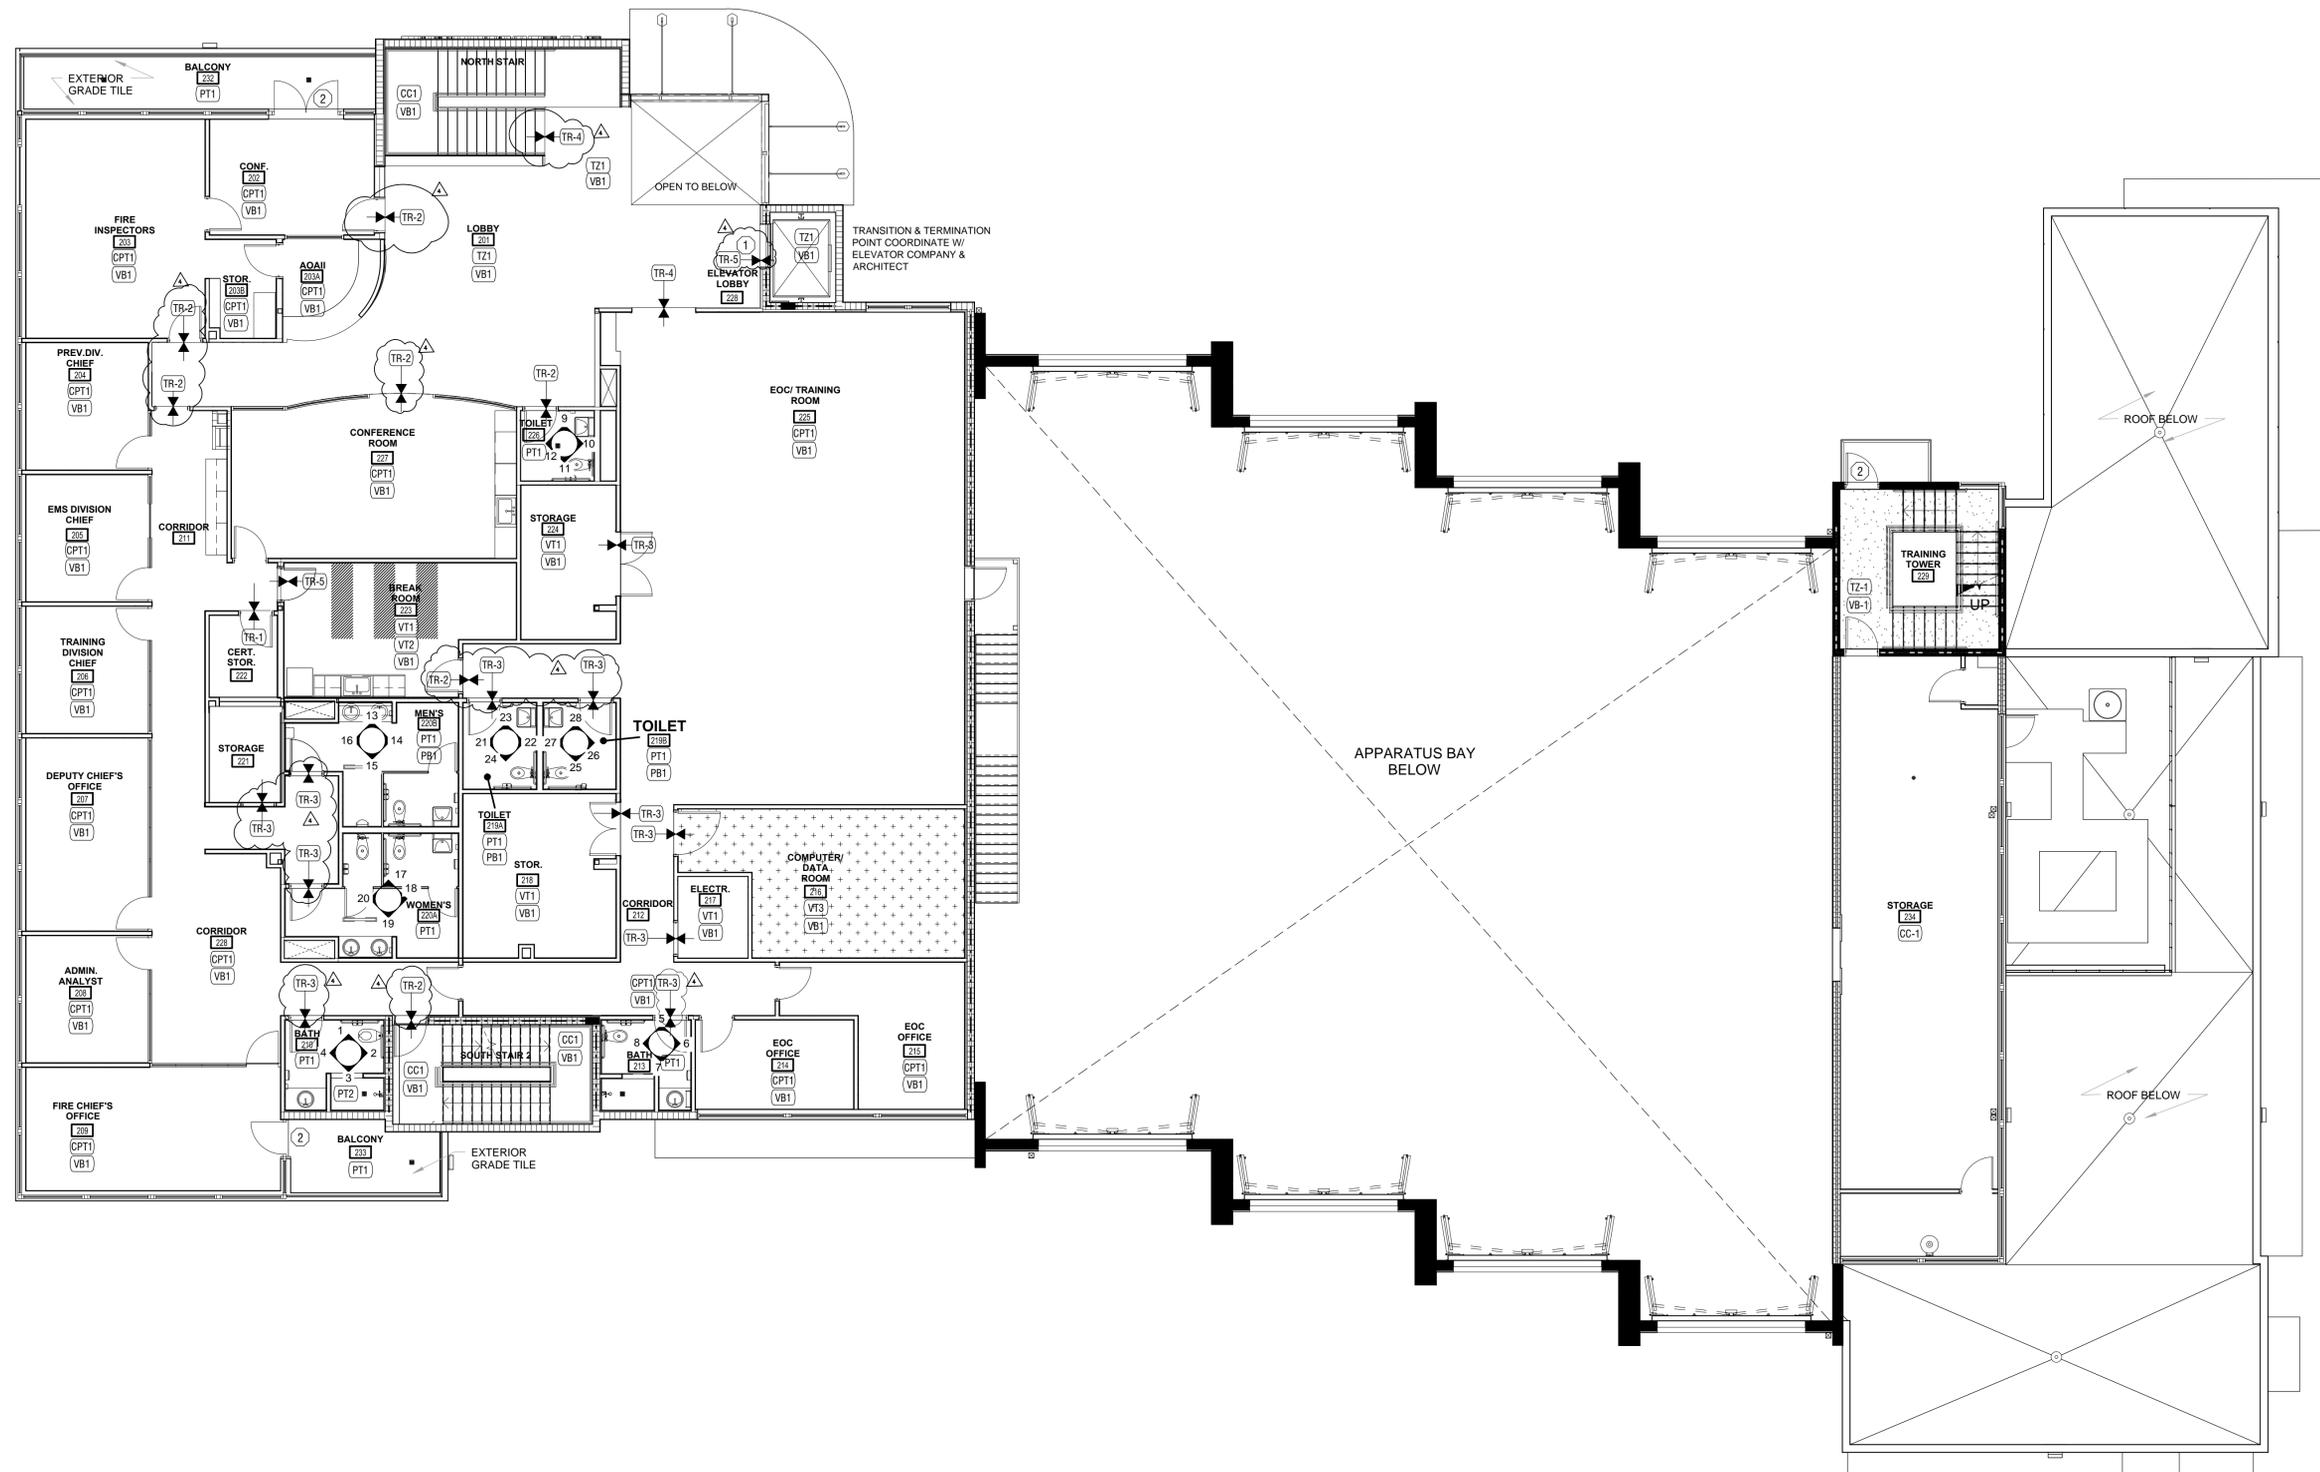


SECOND FLOOR FINISH PLAN

SCALE: 1/8" = 1'-0"



NOTES THIS PLAN:

- 1 GC TO COORDINATE TRANSITION & TERMINATION POINT W/ ELEVATOR CO. AND ARCHITECT.
- 2 COORDINATE FLOOR THRESHOLD TO EXTERIOR OF BUILDING W/ ARCHITECT. REFER TO ARCHITECTURAL DRAWINGS.

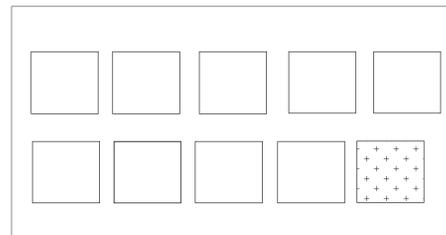

FINISH PLAN LEGEND

KEY NOTE: SEE FLOOR FINISH LEGEND THIS SHEET.

XX# FINISH SCHEDULE NOTATION- SEE SHT ID1 FOR SPECIFICATIONS

TR- TRANSITION POINT BETWEEN FINISHES.

PROJECT NAME:
FIRE & EOC CENTER HALLANDALE, FL
 111 FOSTER ROAD HALLANDALE BEACH, FL. 33009
STATION # 7


SEAL

PROJECT NO:
 2014.17
DRAWN BY: DM
CHECKED BY: AES
DATE: 04-09-2015

FILE NAME:
 1ST FL WALL FINISH PLAN

SHEET NO.

ID-4

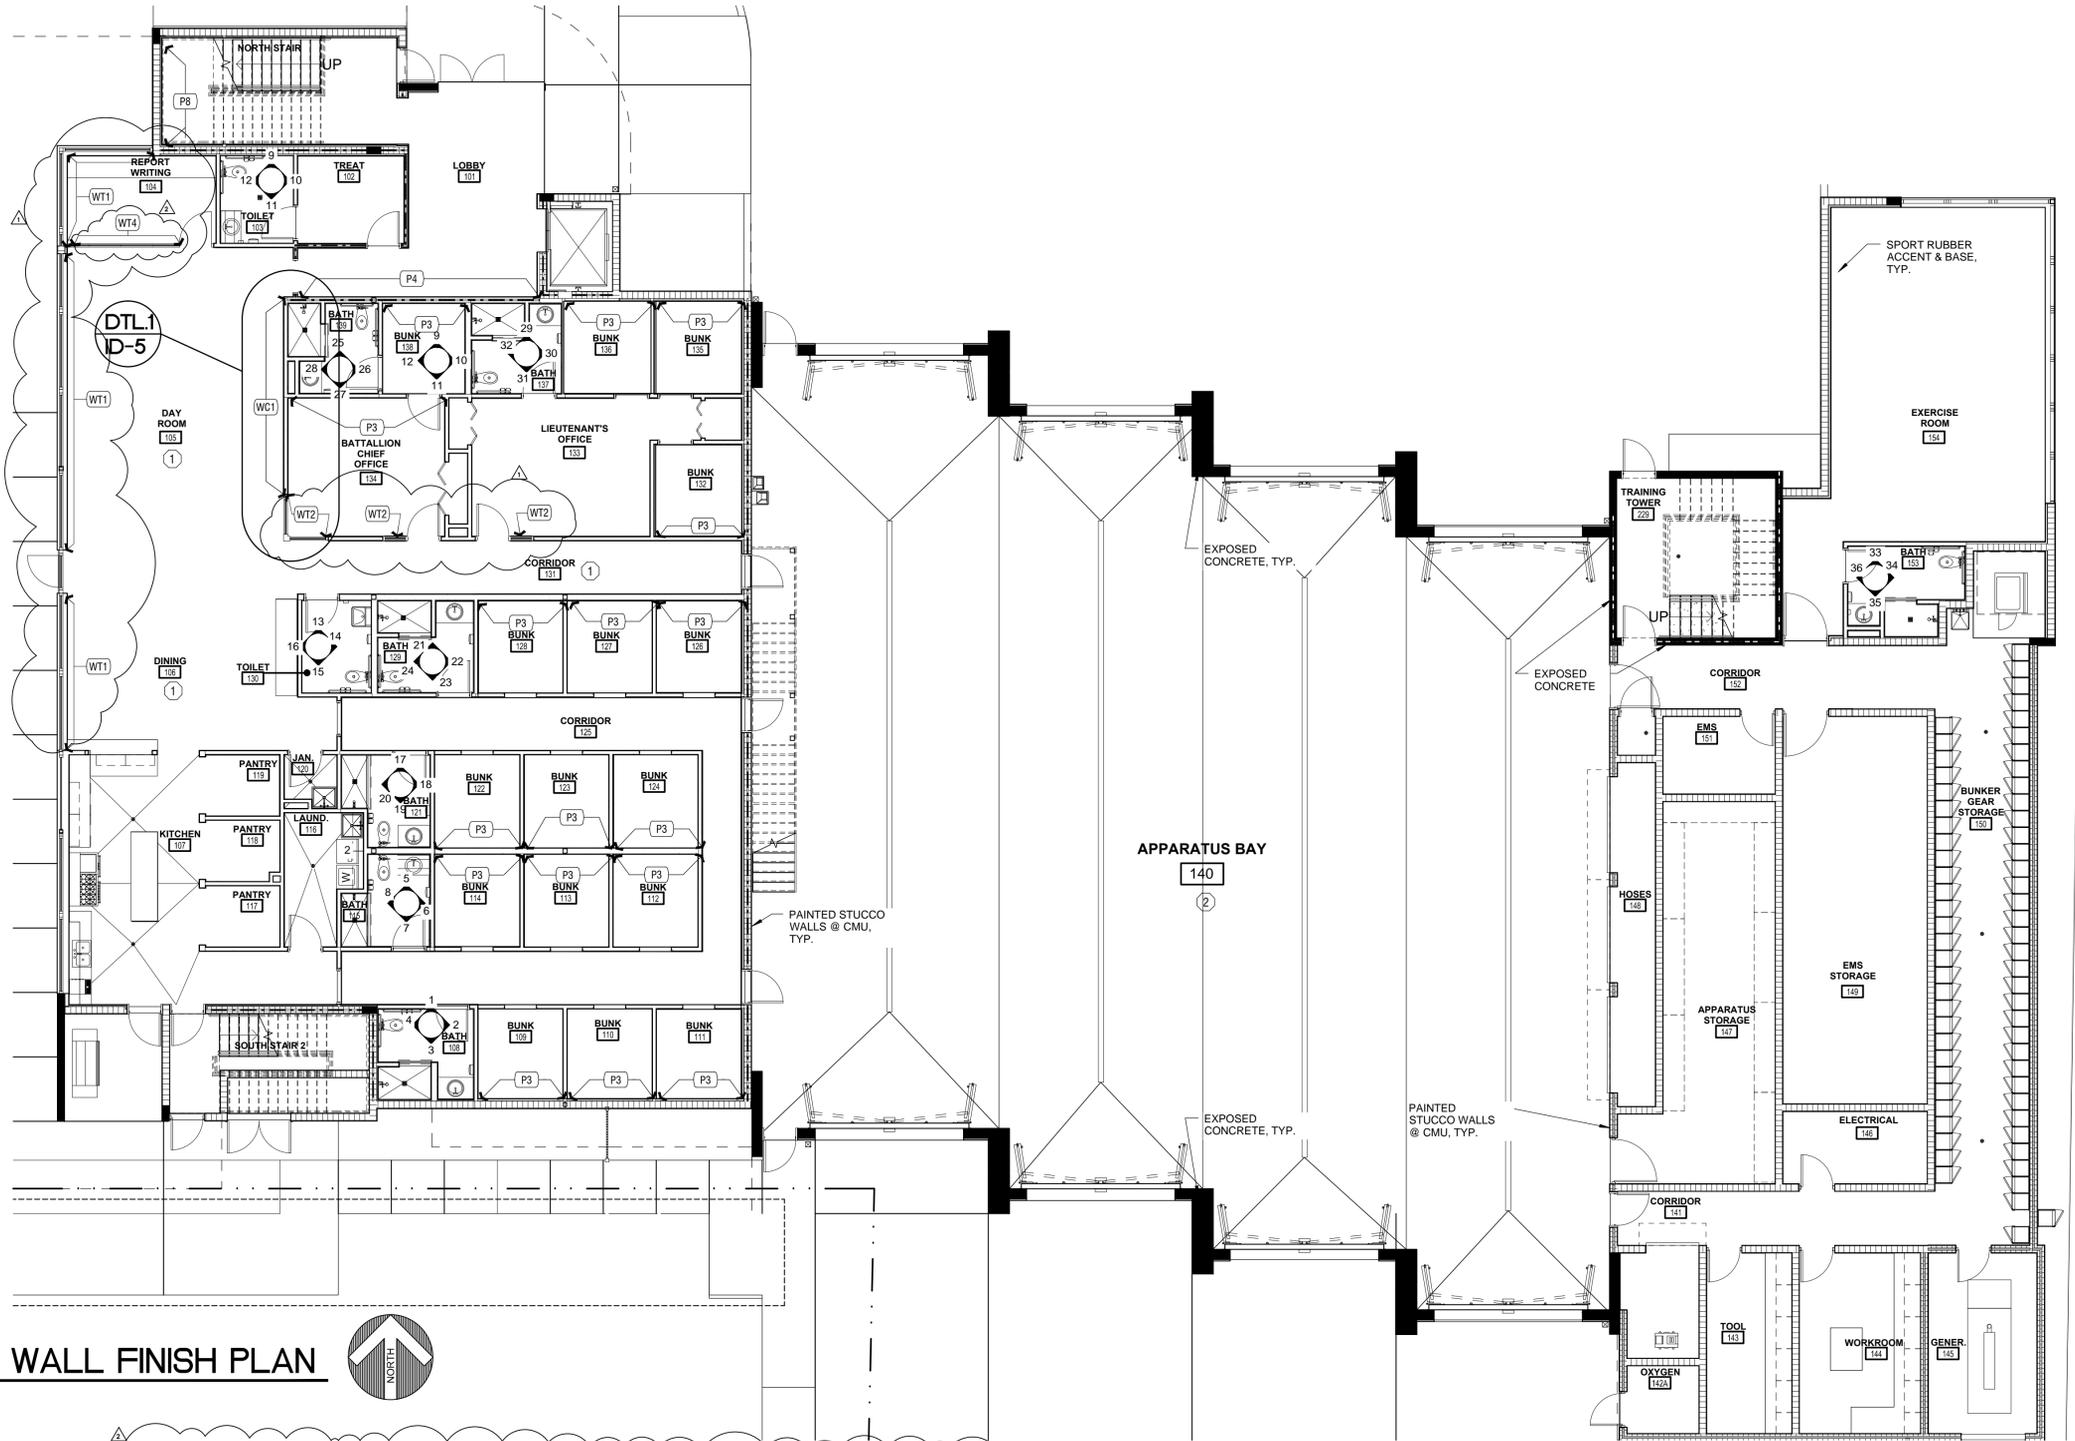

FIRST FLOOR WALL FINISH PLAN
 SCALE: 1/8" = 1'-0"



WINDOW TREATMENT - LOCATION CHART- FIRST FLOOR

FIRST FL	ROOM#	NORTH - WALL	SOUTH - WALL	EAST - WALL	WEST - WALL
REPORT WRITING	104	NA	WT-4	NA	WT-1
DAY ROOM	108	NA	NA	NA	WT-1
DINING	109	NA	NA	NA	WT-1
LIEUTENANT'S OFF.	133	NA	WT-2	NA	NA
BATT. CHIEF OFF.	134	NA	WT-2	NA	WT-2

NOTE: REFER TO ARCHITECTURAL PLANS FOR CEILING HEIGHTS AND WINDOW SCHEDULE

WINDOW TREATMENT SCHEDULE- FIRST FLOOR

WT1	HUNTER DOUGLAS SOLAR SHADES W FACIA- ROLL DOWN - MANUAL MANUFACTURER: AARON'S WINDOW TREATMENTS - 1-800-704-5111 MODEL: PHIFER SHEER WEAVE 2390 COLOR: P14 OYSTER PEARL/GRAY 5% OPENNESS LOCATION: EXTERIOR WINDOW - SEE PLAN AND CHART THIS SHEET FOR LOCATION
WT2	HUNTER DOUGLAS SOLAR SHADES- WITH FACIA. ROLL DOWN - MANUAL MANUFACTURER: AARON'S WINDOW TREATMENTS - 1-800-704-5111 MODEL: PHIFER SHEER WEAVE 2390 COLOR: P14 OYSTER PEARL/GRAY 1% OPENNESS LOCATION: INTERIOR WINDOW - SEE PLAN AND CHART THIS SHEET FOR LOCATION
WT3	HUNTER DOUGLAS SOLAR SHADES- ROLL DOWN - RECESSED CLG. MOTORIZED MANUFACTURER: AARON'S WINDOW TREATMENTS - 1-800-704-5111 MODEL: PHIFER SHEER WEAVE 2390 COLOR: P14 OYSTER PEARL/GRAY 1% OPENNESS SEE ARCHITECTURAL REFLECTED CEILING PLAN FOR LOCATION & DETAIL OF RECESSED POCKET TO BE LOCATED IN CEILING. ALLOW 5" X 5" INSIDE DIMENSION OF THE RECESSED POCKET TO HOUSE SOLAR SHADE. REMOVABLE BOTTOM ENCLOSURE PANEL. LOCATION: INTERIOR RECESSED CEILING - SEE PLAN AND CHART THIS SHEET FOR LOCATION
WT4	HUNTER DOUGLAS SOLAR SHADES W FACIA- ROLL DOWN - MANUAL MANUFACTURER: AARON'S WINDOW TREATMENTS - 1-800-704-5111 MODEL: PHIFER SHEER WEAVE 2390 COLOR: P14 OYSTER PEARL/GRAY 1% OPENNESS LOCATION: CEILING FLUSH MOUNT - SEE FLOOR PLAN AND CHART THIS SHEET FOR LOCATION

NOTES THIS PLAN:

- ALL WALLS PAINTED (P1) UNLESS OTHERWISE INDICATED - REFER TO WALL FINISH PLAN IN COORDINATION WITH SHEET ID1 FINISH SCHEDULE
- ROOMS #140-#152 REFER TO ARCHITECTURAL PLANS FOR ID FINISHES
- WINDOW TREATMENT (WT3) ONLY TO HAVE REMOVABLE BOTTOM ENCLOSURE PANEL

MANUFACTURER: AARON'S WINDOW TREATMENTS - 1-800-704-5111- OR APPROVED EQUAL

WALL FINISH PLAN LEGEND

(XX#) KEY NOTE: SEE DESIGNATED # FOR MORE INFORMATION
 (XX#) FINISH SCHEDULE NOTATION- SEE SHT ID1 FOR SPECIFICATIONS

REVISION:	5-15-15
	5-20-15
	7-10-15
	8-10-15
	8-24-16 BID SET


PROJECT NAME:
FIRE & EOC CENTER HALLANDALE, FL
 1111 FOSTER ROAD HALLANDALE BEACH, FL. 33009
STATION # 7

SEAL

PROJECT NO:
2014.17
DRAWN BY: DM
CHECKED BY: AES
DATE: 04-09-2015

FILE NAME:
2ND FL
WALL
FINISH
PLAN

SHEET NO.
ID-5

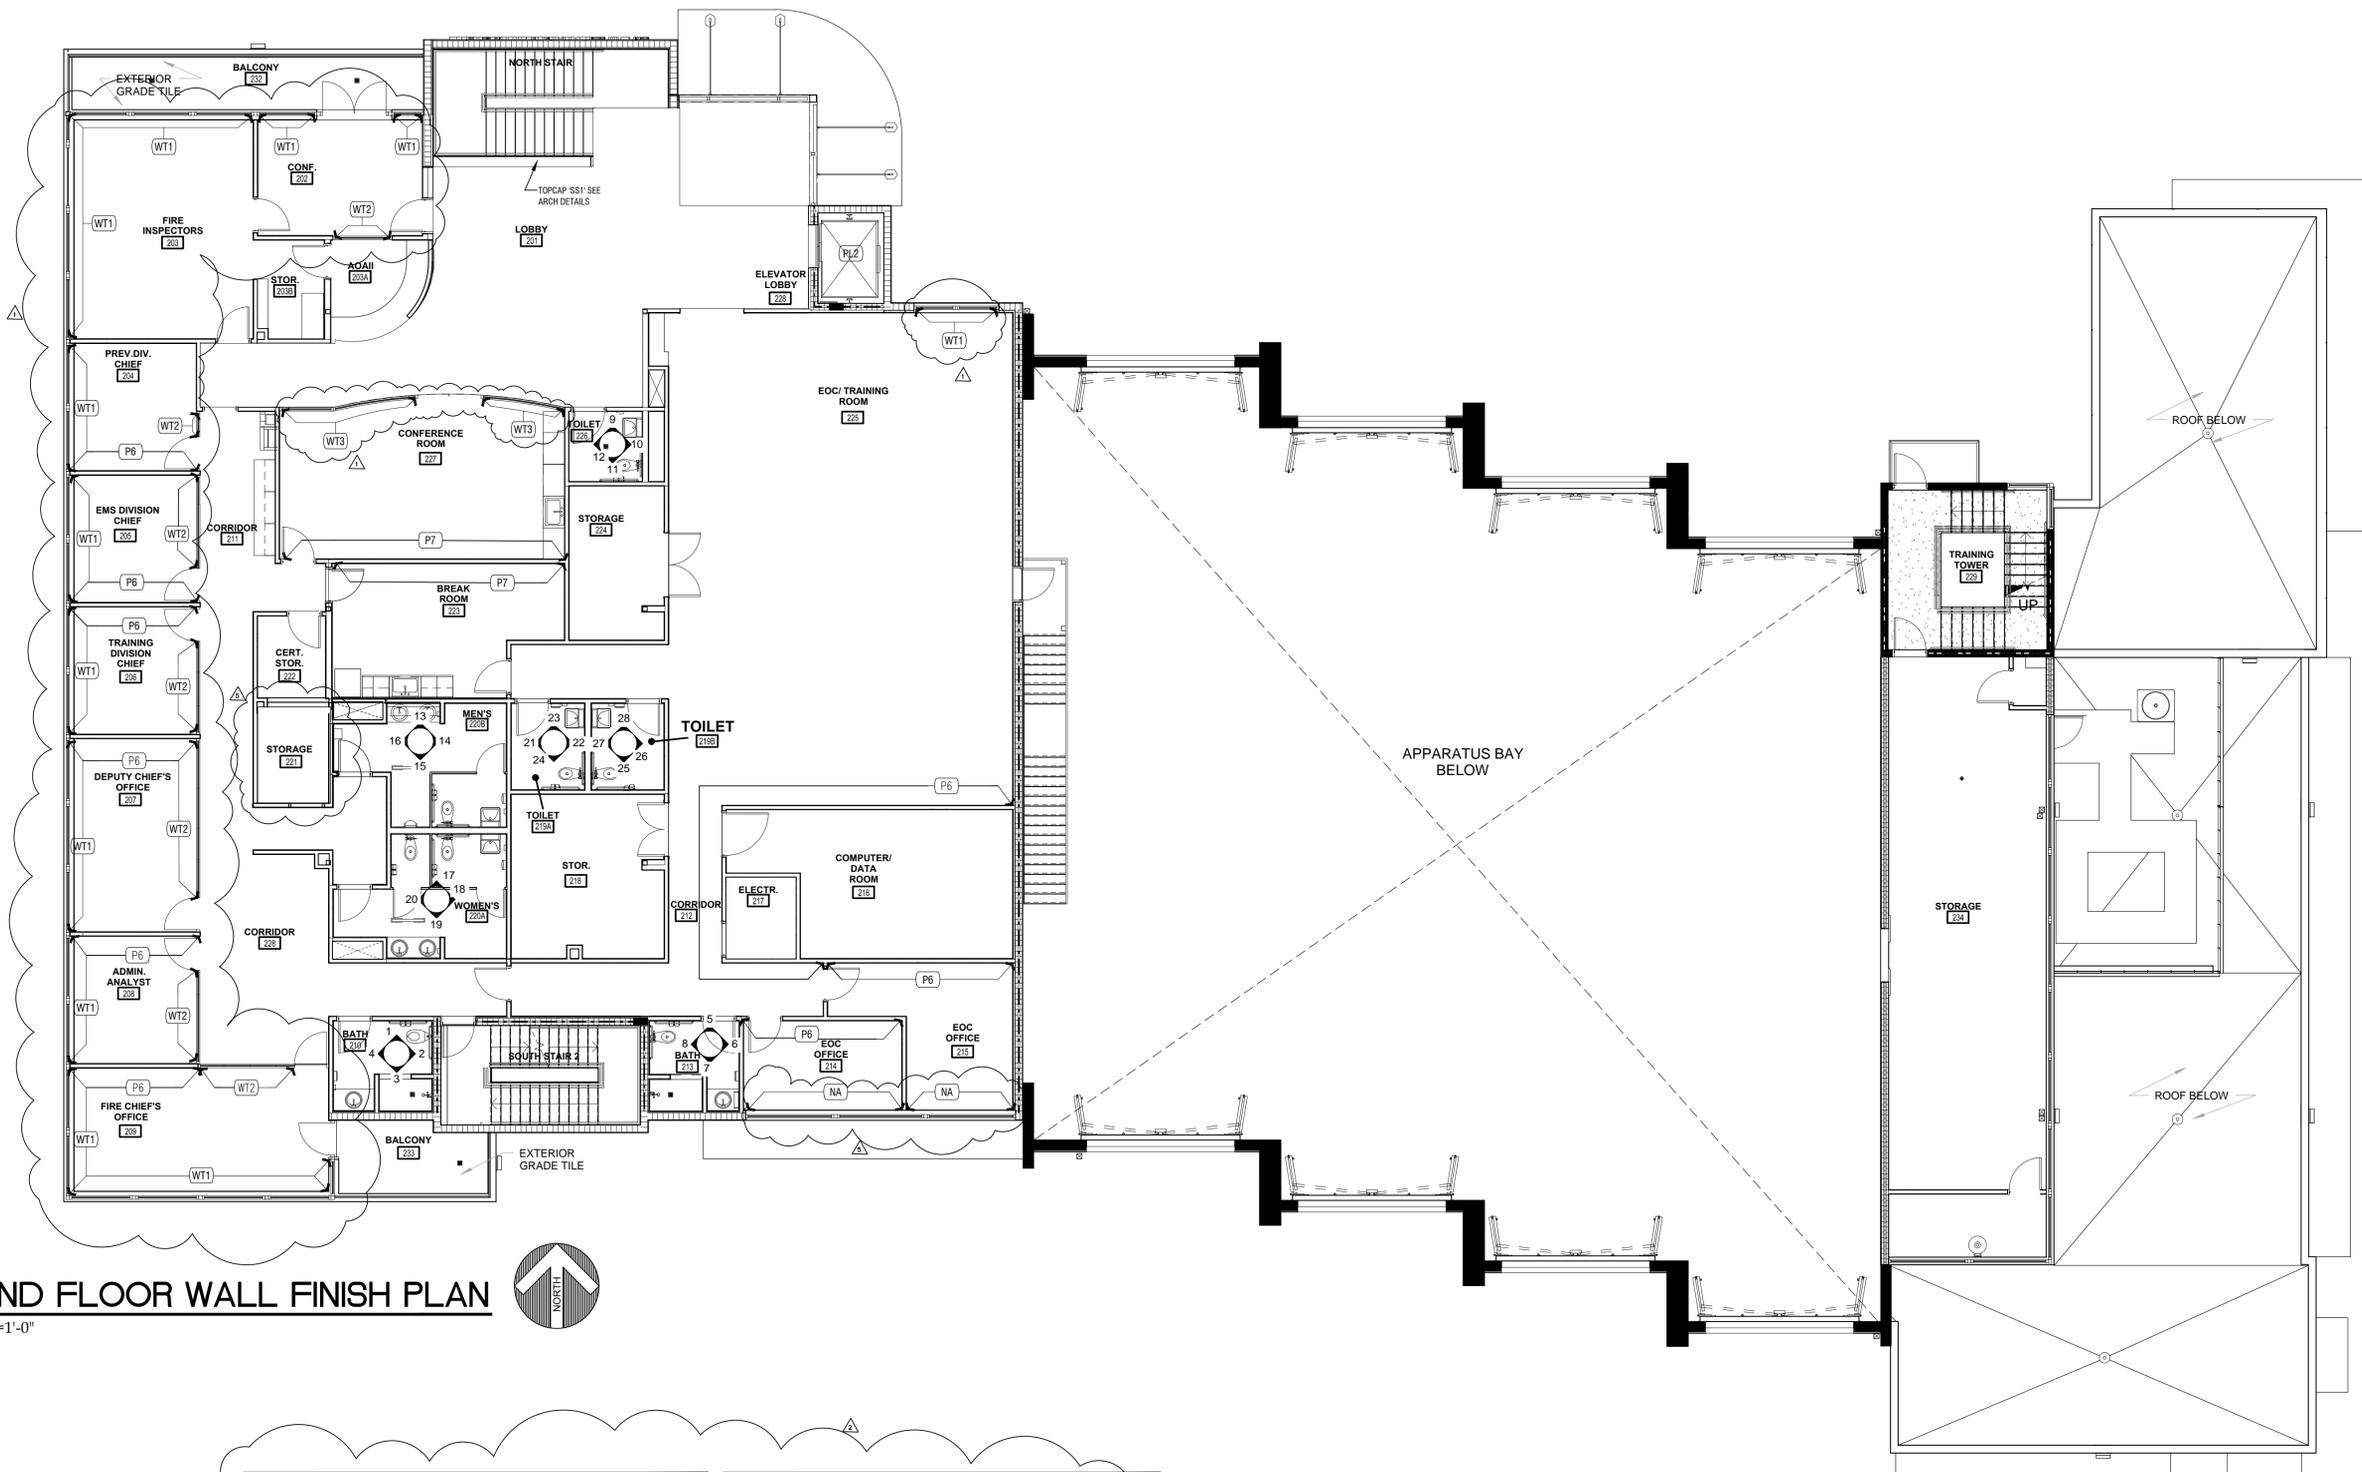

SECOND FLOOR WALL FINISH PLAN
 SCALE: 1/8" = 1'-0"

WINDOW TREATMENT - LOCATION CHART- SECOND FL.

SECOND FL	ROOM#	NORTH - WALL	SOUTH - WALL	EAST - WALL	WEST - WALL
CONFERENCE RM	202	WT-1	WT-2	NA	NA
FIRE INSPECTORS	203	WT-1	NA	NA	WT-1
PRE DIV CHIEF	204	NA	NA	WT-2	WT-1
EMS DIV CHIEF	205	NA	NA	WT-2	WT-1
TRAINING DIV CHIEF	206	NA	NA	WT-2	WT-1
DEPUTY CHIEF'S OFF	207	NA	NA	WT-2	WT-1
ADMIN ANALYST	208	NA	NA	WT-2	WT-1
FIRE CHIEF'S OFF	209	WT-2	WT-1	WT-1	WT-1
EOC OFFICE	214	NA	WT-1	NA	NA
EOC OFFICE	215	NA	NA	NA	NA
EOC TRAINING	225	WT-1	NA	NA	NA
CONFERENCE RM	227	WT-3	NA	NA	NA

NOTE: REFER TO ARCHITECTURAL PLANS FOR CEILING HEIGHTS AND WINDOW SCHEDULE.

WINDOW TREATMENT SCHEDULE- FIRST FLOOR

WT1	HUNTER DOUGLAS SOLAR SHADES W FACIA- ROLL DOWN - MANUAL MANUFACTURER: AARONS WINDOW TREATMENTS - 1-800-704-5111 MODEL: P14 OYSTER PEARL GRAY 5% OPENNESS COLOR: P14 OYSTER PEARL GRAY 5% OPENNESS LOCATION: EXTERIOR WINDOW - SEE PLAN AND CHART FOR LOCATION THIS SHEET
WT2	HUNTER DOUGLAS SOLAR SHADES- WITH FACIA- ROLL DOWN - MANUAL MANUFACTURER: AARONS WINDOW TREATMENTS - 1-800-704-5111 MODEL: P14 OYSTER PEARL GRAY 1% OPENNESS COLOR: P14 OYSTER PEARL GRAY 1% OPENNESS LOCATION: INTERIOR WINDOW - SEE PLAN AND CHART THIS SHEET FOR LOCATION
WT3	HUNTER DOUGLAS SOLAR SHADES- ROLL DOWN - RECESSED CLG. MOTORIZED MANUFACTURER: AARONS WINDOW TREATMENTS - 1-800-704-5111 MODEL: P14 OYSTER PEARL GRAY 1% OPENNESS COLOR: P14 OYSTER PEARL GRAY 1% OPENNESS SEE ARCHITECTURAL REFLECTED CEILING PLAN FOR LOCATION & DETAIL OF RECESSED POCKET TO BE LOCATED IN CEILING. ALLOW 2" X 2" INSIDE DIMENSION OF THE RECESSED POCKET TO HOUSE SOLAR SHADE. REMOVABLE BOTTOM ENCLOSURE PANEL. LOCATION: INTERIOR RECESSED CEILING - SEE PLAN AND CHART THIS SHEET FOR LOCATION
WT4	HUNTER DOUGLAS SOLAR SHADES W FACIA- ROLL DOWN - MANUAL MANUFACTURER: AARONS WINDOW TREATMENTS - 1-800-704-5111 MODEL: P14 OYSTER PEARL GRAY 1% OPENNESS COLOR: P14 OYSTER PEARL GRAY 1% OPENNESS LOCATION: CEILING FLUSH MOUNT - SEE FLOOR PLAN AND CHART THIS SHEET FOR LOCATION

NOTES THIS PLAN:

- ALL WALLS PAINTED (P1) UNLESS OTHERWISE INDICATED - REFER TO WALL FINISH PLAN IN COORDINATION WITH SHEET ID1 FINISH SCHEDULE
- WINDOW TREATMENT (WT3) ONLY TO HAVE REMOVABLE BOTTOM ENCLOSURE PANEL

MANUFACTURER: AARONS WINDOW TREATMENTS - 1-800-704-5111 - OR APPROVED EQUAL


WALL FINISH PLAN LEGEND

XX# KEY NOTE. SEE DESIGNATED # FOR MORE INFORMATION

XX# FINISH SCHEDULE NOTATION- SEE SHT ID1 FOR SPECIFICATIONS


FIRST FLOOR FURNITURE PLAN

SCALE: 1/8" = 1'-0"

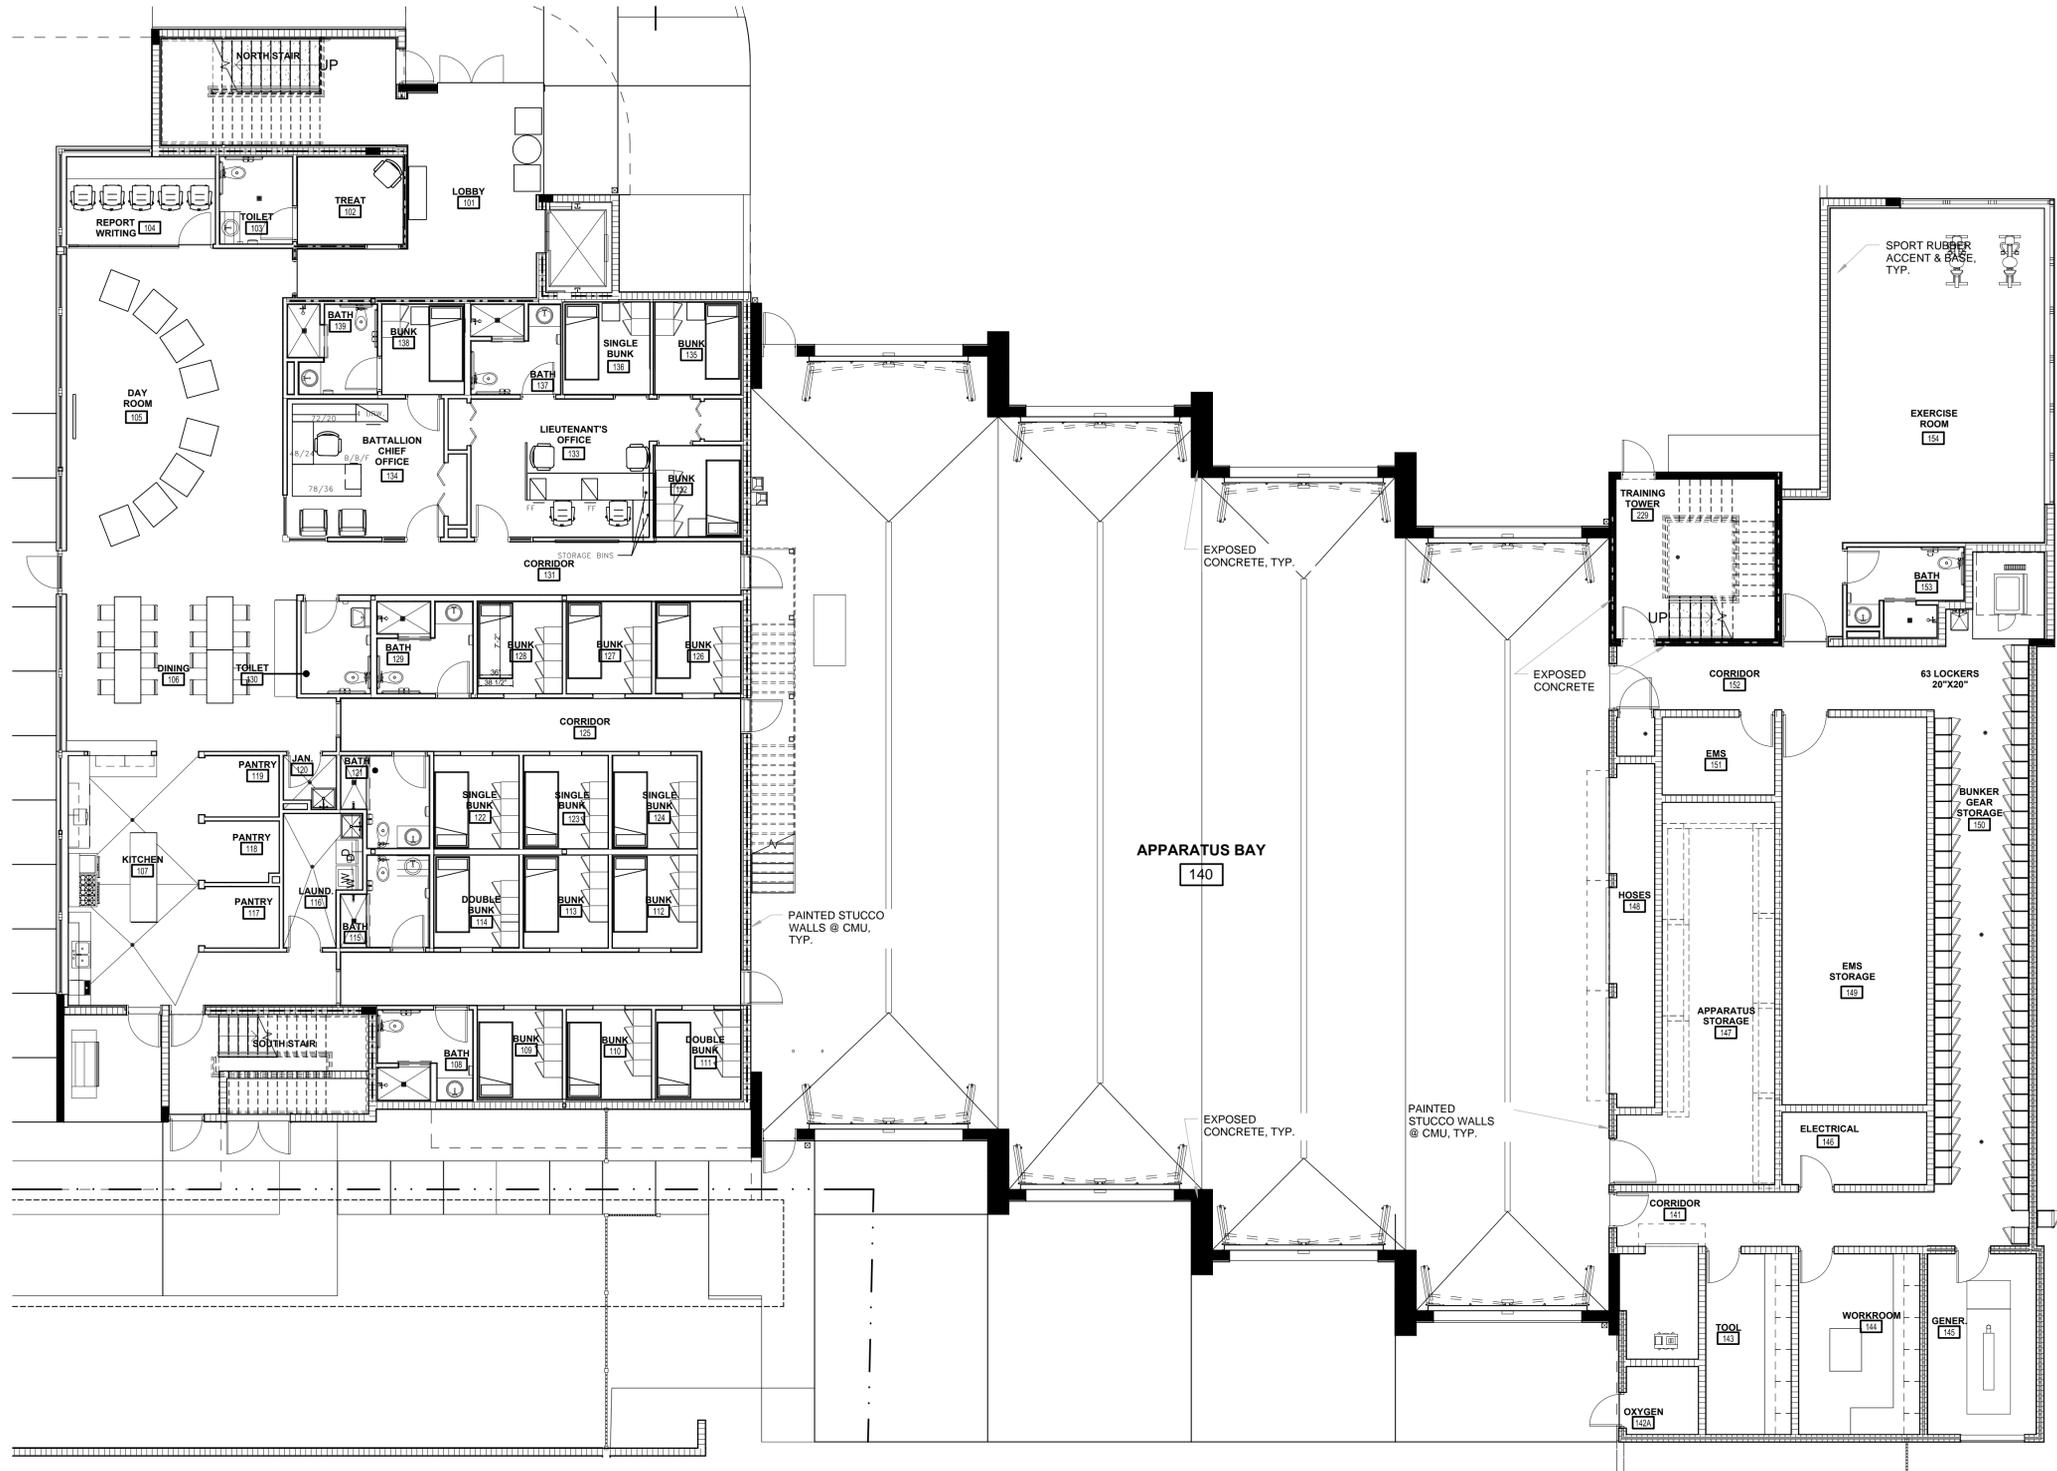

NOTES THIS PLAN:

① FURNITURE TAG PER DESIGN DRAWINGS REFER TO MANUFACTURER'S DRAWINGS FOR DETAILED LAYOUT & COMPONENTRY

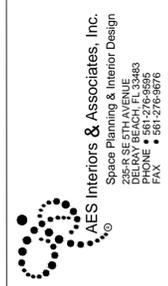

AES Interiors & Associates, Inc.
 Space Planning & Interior Design
 2500 SE 6TH AVENUE
 SUITE 100
 FORT LAUDERDALE, FL 33304
 PHONE: 561-276-8288
 FAX: 561-276-8676

PROJECT NAME:
FIRE & EOC CENTER STATION # 7
 111 FOSTER ROAD HALLANDALE, FL.
STATION # 7

SEAL

PROJECT NO: 2014.17
DRAWN BY: DM
CHECKED BY: AES
DATE: 04-09-2015

FILE NAME:
 1ST FL
 FURNITURE
 PLAN

SHEET NO.
 ID-6

REVISION	DATE	BY
1	5-15-15	
2	8-24-15	BID SET


PROJECT NAME:
FIRE & EOC CENTER HALLANDALE, FL
 111 FOSTER ROAD HALLANDALE BEACH, FL. 33009
STATION # 7

SEAL

PROJECT NO:
 2014.17
DRAWN BY: DM
CHECKED BY: AES
DATE: 04-09-2015

FILE NAME:
 2ND FL
 FURNITURE
 PLAN

SHEET NO.
 ID-7

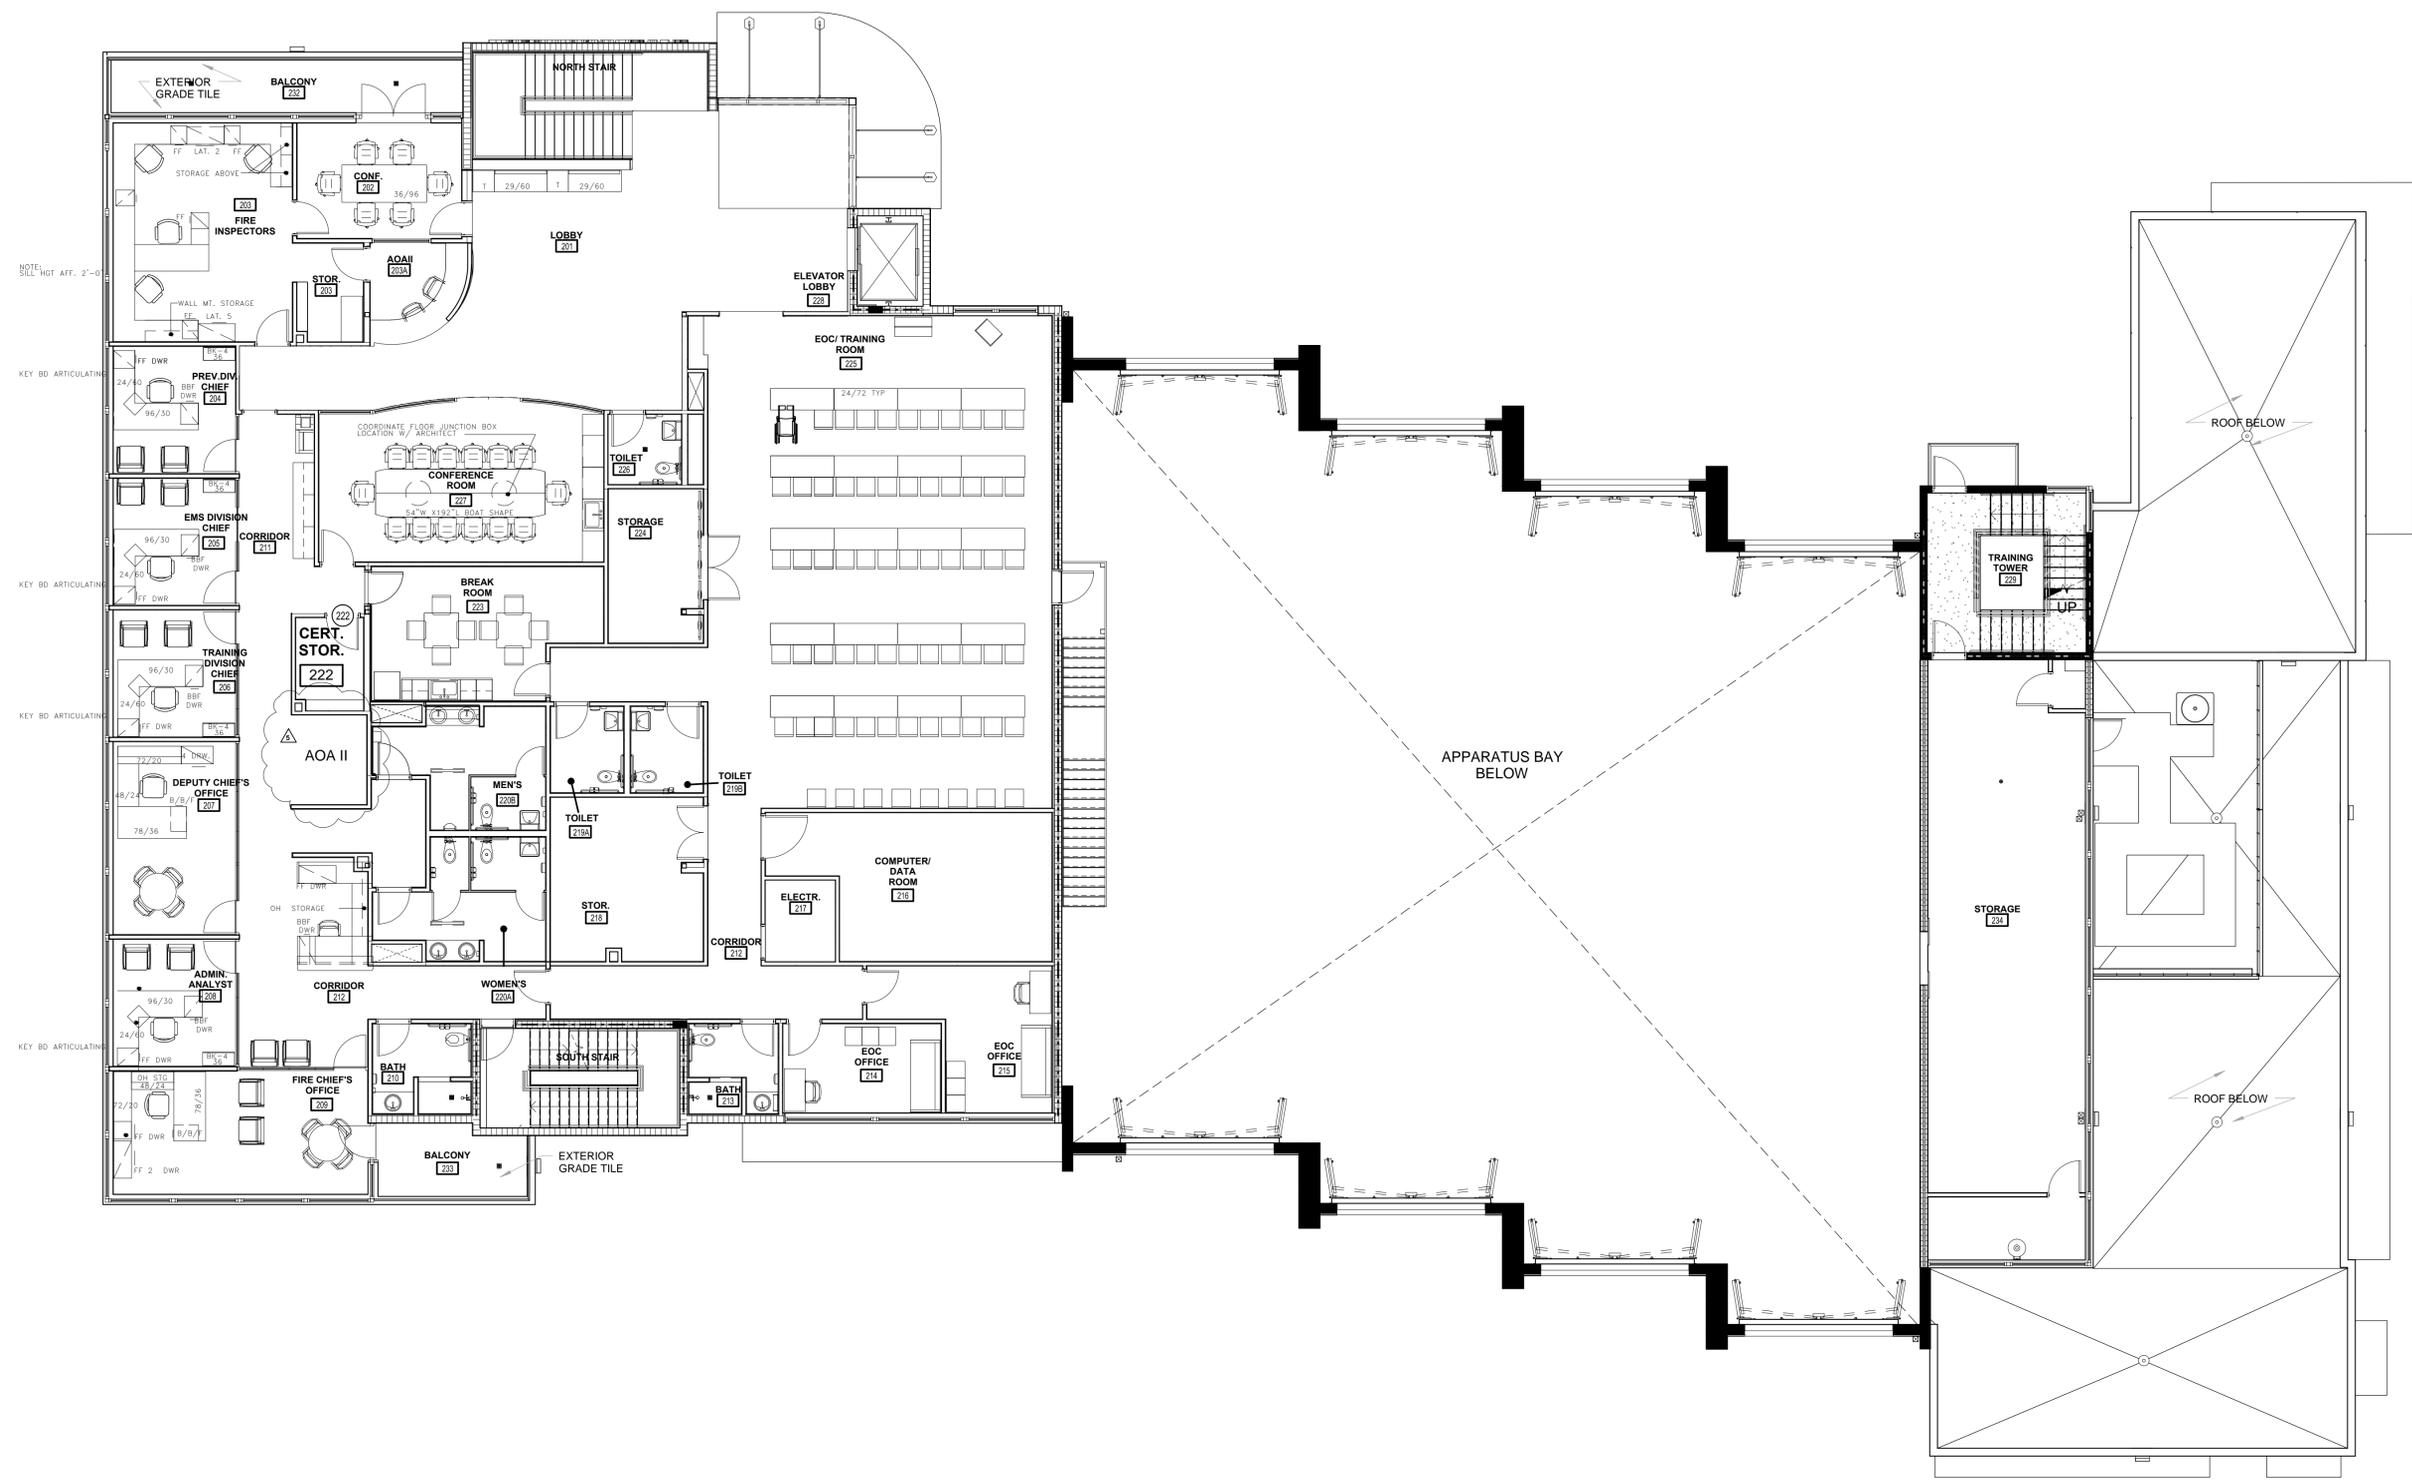


SECOND FLOOR FURNITURE PLAN
 SCALE: 1/8" = 1'-0"




NOTES THIS PLAN:
 1 FURNITURE TAG PER DESIGN DRAWINGS REFER TO MANUFACTURER'S DRAWINGS FOR DETAILED LAYOUT & COMPONENTRY


NOTE: REFER TO ARCHITECTURAL DRAWING SET FOR WALL ELEVATION LOCATIONS AND DETAILS.

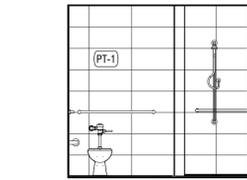


32 BATH 137 - W
A5.11 1/4" = 1'-0"

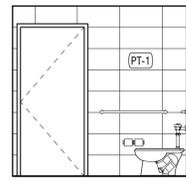


31 BATH 137 - S
A5.11 1/4" = 1'-0"

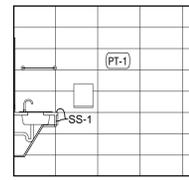


30 BATH 137 - E
A5.11 1/4" = 1'-0"

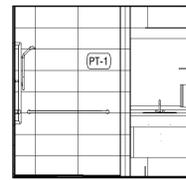


29 BATH 137 - N
A5.11 1/4" = 1'-0"

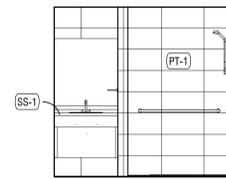


28 BATH 139 - W
A5.11 1/4" = 1'-0"

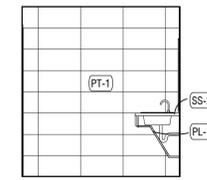


27 BATH 139 - S
A5.11 1/4" = 1'-0"

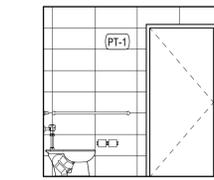


26 BATH 139 - E
A5.11 1/4" = 1'-0"

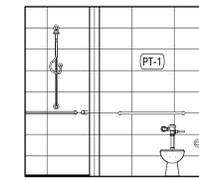


25 BATH 139 - N
A5.11 1/4" = 1'-0"

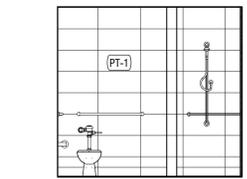


24 BATH 129 - W
A5.11 1/4" = 1'-0"

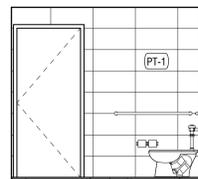


23 BATH 129 - S
A5.11 1/4" = 1'-0"

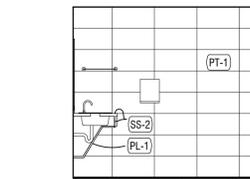


22 BATH 129 - E
A5.11 1/4" = 1'-0"

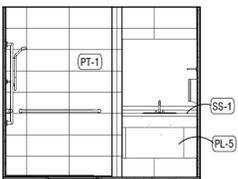


21 BATH 129 - N
A5.11 1/4" = 1'-0"

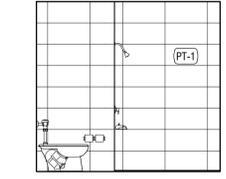


20 BATH 121 - W
A5.11 1/4" = 1'-0"

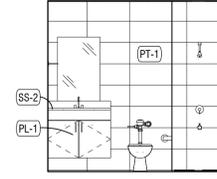


19 BATH 121 - S
A5.11 1/4" = 1'-0"

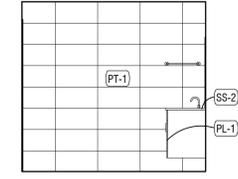


18 BATH 121 - E
A5.11 1/4" = 1'-0"

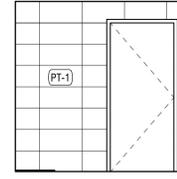


17 BATH 121 - N
A5.11 1/4" = 1'-0"

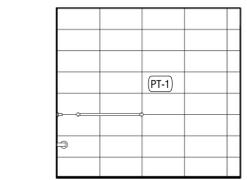


16 TOILET 130 - W
A5.11 1/4" = 1'-0"

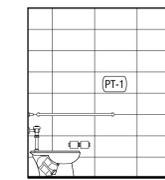


15 TOILET 130 - S
A5.11 1/4" = 1'-0"

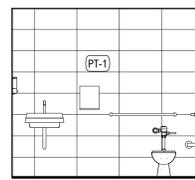


14 TOILET 130 - E
A5.11 1/4" = 1'-0"

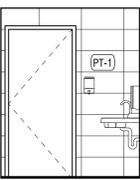


13 TOILET 130 - N
A5.11 1/4" = 1'-0"

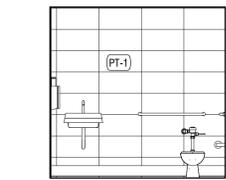


12 TOILET 103 - W
A5.11 1/4" = 1'-0"

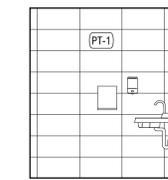


11 TOILET 103 - S
A5.11 1/4" = 1'-0"

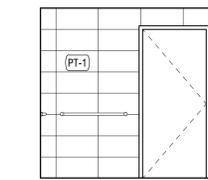


10 TOILET 103 - E
A5.11 1/4" = 1'-0"

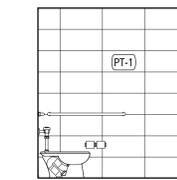


9 TOILET 103 - N
A5.11 1/4" = 1'-0"

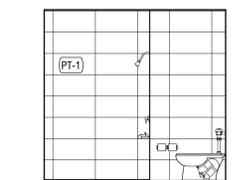


8 BATH 115 - W
A5.11 1/4" = 1'-0"

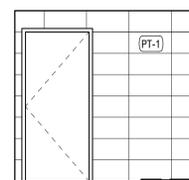


7 BATH 115 - S
A5.11 1/4" = 1'-0"

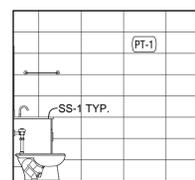


6 BATH 115 - E
A5.11 1/4" = 1'-0"

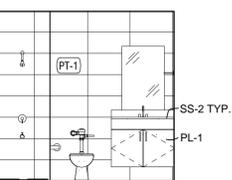


5 BATH 115 - N
A5.11 1/4" = 1'-0"

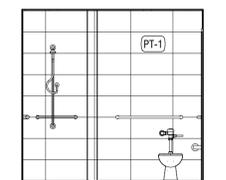


4 BATH 108 - W
A5.11 1/4" = 1'-0"

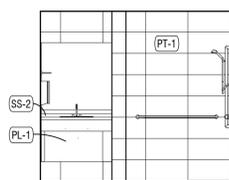


3 BATH 108 - S
A5.11 1/4" = 1'-0"

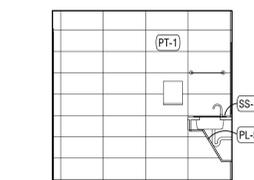


2 BATH 108 - E
A5.11 1/4" = 1'-0"

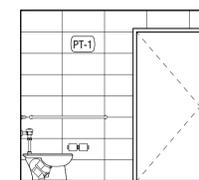


1 BATH 108 - N
A5.11 1/4" = 1'-0"

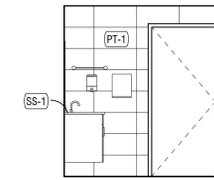


36 BATH 153 - W
A5.11 1/4" = 1'-0"

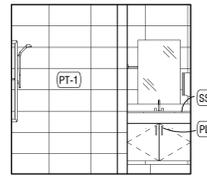

35 BATH 153 - S
A5.11 1/4" = 1'-0"

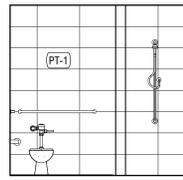

34 BATH 153 - E
A5.11 1/4" = 1'-0"

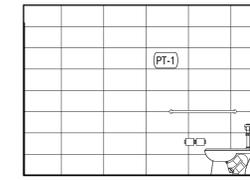

33 BATH 153 - N
A5.11 1/4" = 1'-0"

REVISION:

FIRE & EOC CENTER HALLANDALE, FL
111 FOSTER ROAD HALLANDALE BEACH, FL. 33009
STATION # 7

PROJECT NAME:


SEAL

PROJECT NO:
2014.17
DRAWN BY: DM
CHECKED BY: AES
DATE: 04-09-15

FILE NAME:
FINISH ELEVATIONS PLAN


SHEET NO.

ID-8

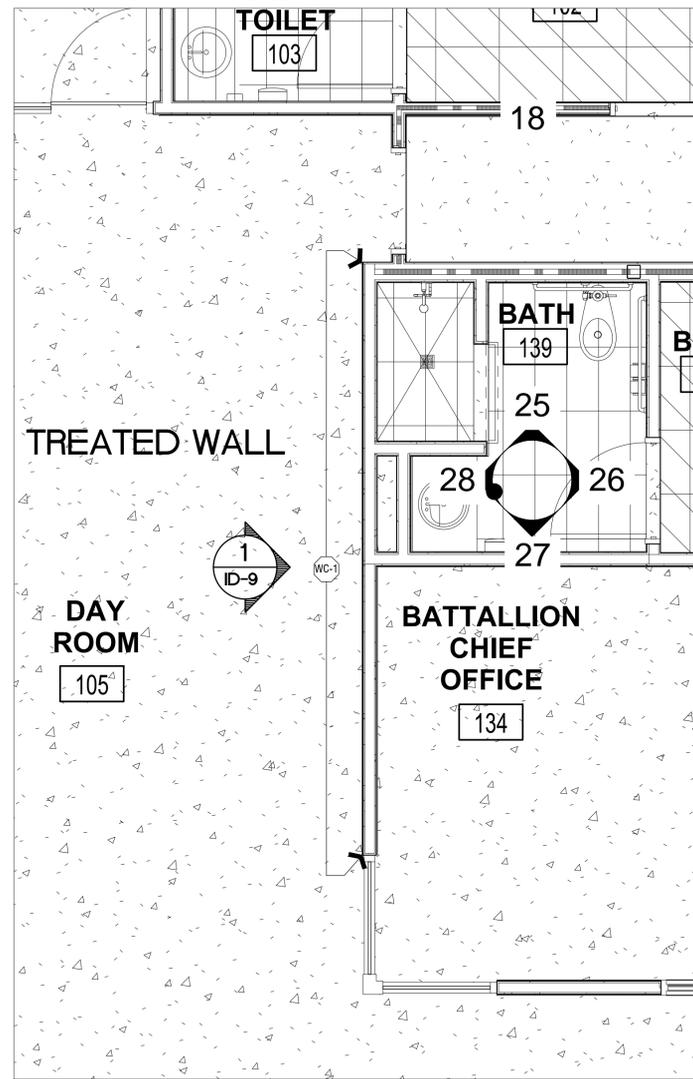



PARTIAL FIRST FLOOR PLAN

SCALE: 3/8" = 1'-0"

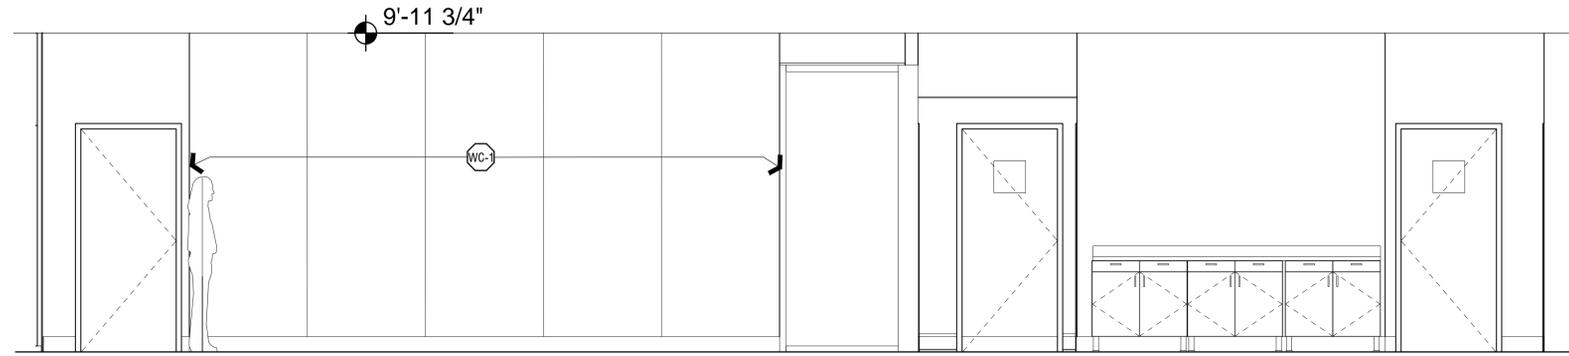

DAYROOM 105-E ELEVATION

3/8" = 1'-0"

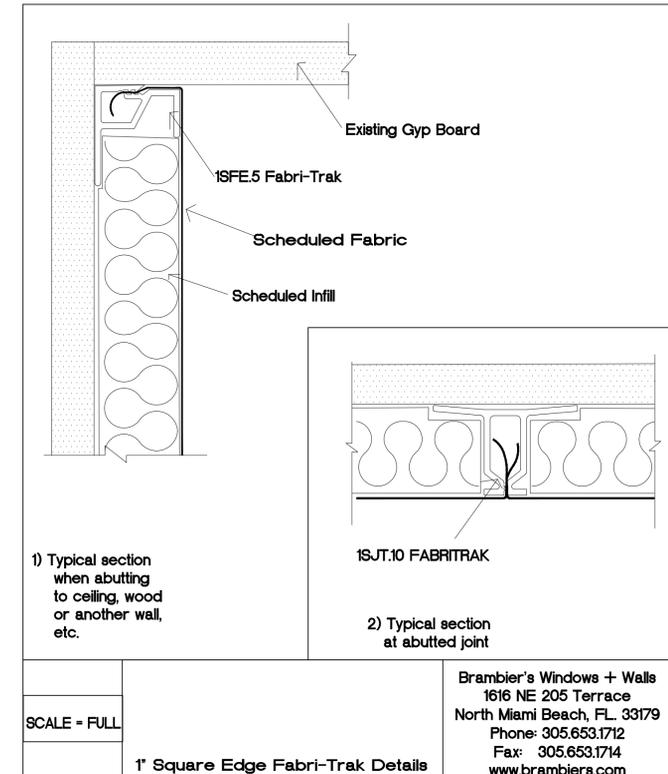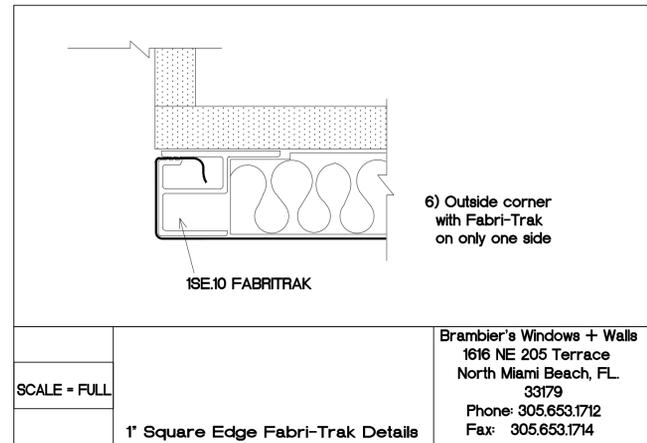

DLT.1 - FABRI TRAK DETAILS PER MANUFACTURER

NOTES THIS PLAN:

(WC-1) REFER TO SPECIFICATIONS SHEET ID1 - MANUFACTURER: KNOLL TEXTILES INC. NAME: ALIAS 2477 COLLECTION. STYLE NUMBER: W0155399 (UNBACKED). WRAPPED ACOUSTICAL PANELS. CONTENT: POLYETHYLENE 100% FIBER. TEFLOW SOIL & STAIN REPELLENT. TYPEWEIGHT: TYPE II 10.5 OZ. PER LIN. YD. WIDTH: 54" FLAME RESISTANCE: ASTM E 84 CLASS A. MAINTENANCE: WATER BASED CLEANING AGENT OR DILUTED HOUSEHOLD BLEACH. ENVIRONMENTAL: 100% SOLUTION DYED FIBER. GREENGUARD CERTIFIED CONTRIBUTES TO LEED CERTIFICATION.

NOTE: THIS FABRIC TO BE PURCHASED BY BRAMBIER'S INC. THEN FABRICATED INTO FABRI TRAK PANEL PRODUCT. (SEE TECHNICAL PRODUCT INFORMATION IN THE ARCHITECTURAL SPECIFICATIONS).

TENANT APPROVAL

I HAVE REVIEWED THESE PLANS AND THEY CONFORM TO OUR REQUIREMENTS. I UNDERSTAND THAT ANY MODIFICATIONS TO THESE PLANS WILL BE AN ADDITIONAL SERVICE.

ACCEPTED AS IS:

ACCEPTED AS NOTED:

UNACCEPTED:

CLIENT SIGNATURE: _____

REVISION:	
-----------	--

SEAL

PROJECT NO:	2014.17
DRAWN BY:	DM
CHECKED BY:	AES
DATE:	04-09-15

FABR-TRAK WALL PANELS

SHEET NO.
ID-9